


### WELL PLUGGING RECORD

STATE OF KANSAS  
 STATE CORRELATION COMMISSION  
 Give All Information Completely  
 Make Required Affidavit  
 Mail or Deliver Report to  
 Conservation Division  
 State Corporation Commission  
 211 No. Broadway  
 Wichita, Kansas

NORTH

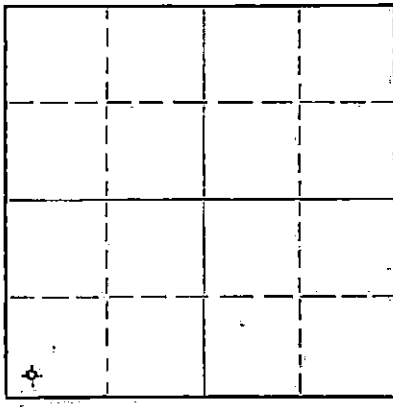

Locate well correctly on above Section Plat

Rice County. Sec. 21 Twp. 20S Rge. 9 (E) W (W)  
 Location as "NE/CNWxSWx" or footage from lines SW/4 SW/4 SW/4  
 Operator Birmingham-Bartlett Drilling Co.  
 Lease Owner Birmingham-Bartlett Drilling Co.  
 Lease Name McGlynn Well No. 1  
 Office Address 300 Kaufman Bldg., Wichita 2, Kansas  
 Character of Well (completed as Oil, Gas or Dry Hole) Dry Hole  
 Date well completed February 20, 19 57  
 Application for plugging filed (verbal) February 20, 19 57  
 Application for plugging approved (verbal) February 20, 19 57  
 Plugging commenced February 20, 19 57  
 Plugging completed February 20, 19 57  
 Reason for abandonment of well or producing formation Dry Hole

If a producing well is abandoned, date of last production \_\_\_\_\_ 19\_\_\_\_  
 Was permission obtained from the Conservation Division or its agents before plugging was commenced? Yes

Name of Conservation Agent who supervised plugging of this well Ruel Durkee  
 Producing formation \_\_\_\_\_ Depth to top \_\_\_\_\_ Bottom \_\_\_\_\_ Total Depth of Well 3305 Feet  
 Show depth and thickness of all water, oil and gas formations.

#### OIL, GAS OR WATER RECORDS

#### CASING RECORD

FORMATION	CONTENT	FROM	TO	SIZE	PUT IN	PULLED OUT
		0	248'	8-5/8"	248'	None

Describe in detail the manner in which the well was plugged, indicating where the mud fluid was placed and the method or methods used in introducing it into the hole. If cement or other plugs were used, state the character of same and depth placed, from \_\_\_\_\_ feet to \_\_\_\_\_ feet for each plug set.

Set bottom plug at 230'. Mix and pour 15 sacks cement through 7 joints drill pipe. Set top plug at 40'. Mix and pour 5 sacks cement. Filled with dirt to surface.

(If additional description is necessary, use BACK of this sheet)  
 Name of Plugging Contractor Birmingham-Bartlett Drilling Co.  
 Address 300 Kaufman Bldg., Wichita 2, Kansas

STATE OF Kansas, COUNTY OF Sedgwick, ss.  
Richard Hindery, Partner of Birmingham-Bartlett Drilling Co., owner and operator  
 well, being first duly sworn on oath, says: That I have knowledge of the facts, statements, and matters herein contained and the log of the above-described well as filed and that the same are true and correct. So help me God. BIRMINGHAM-BARTLETT DRILLING CO.  
 (Signature) By Richard Hindery Partner  
300 Kaufman Bldg., Wichita 2, Kansas  
 (Address)

SUBSCRIBED AND SWORN TO before me this 21st day of February, 19 57

My commission expires October 2, 1958.

Beverly Larson  
 Notary Public.

**PLUGGING**  
 FILE SEC. 21 T. 20 R. 9W  
 BOOK PAGE 143 LINE 27

FEB 25 1957 2-23-57  
 CONSERVATION DIVISION  
 Wichita, Kansas

McGLYNN NO. 1 WELL

LOCATION: SW/4 SW/4 SW/4  
Section 21-20S-9W  
Rice County, Kansas

SPUDED: 2-11-57  
COMPLETED: 2-20-57

OWNER, OPERATOR  
and CONTRACTOR: Birmingham-Bartlett Drilling Co.  
300 Kaufman Building  
Wichita 2, Kansas

SURFACE CASING: 8-5/8" surface casing cemented  
at 248' with 200 sacks cement  
and 3 c. c.

OIL STRING: None set. Dry and abandoned.  
Plugged 2-20-57.

L O G

(Figures indicate bottom of formation)

0	60	Clay and sand
	247	Shale and shells
	336	Red bed
	356	Anhydrite
	1150	Shale and shells
	1995	Lime and shale
	2410	Shale and shells
	2822	Lime
	2953	Shale
	3305	Lime
	3305	Rotary Total Depth

The undersigned, Richard Hindery, one of the partners of Birmingham-Bartlett Drilling Co., hereby certifies that the above is a true and correct log of the formations encountered in drilling the McGlynn No. 1 Well as shown in the daily drilling reports.

BIRMINGHAM-BARTLETT DRILLING CO.

By Richard Hindery

Subscribed and sworn to before me this  
21st day of February, 1957.

Beverly Larson  
Notary Public

My commission expires October 2, 1958.

RECEIVED  
STATE CORPORATION COMMISSION

PLUGGING	
FILE SEC	21-T-20-R-9W
BOOK PAGE	143 LINE 27

FEB 25 1957

CONSERVATION DIVISION  
Wichita, Kansas