


WELL PLUGGING RECORD

Give All Information Completely  
Make Required Affidavit  
Mail or Deliver Report to:  
Conservation Division  
State Corporation Commission  
500 Biting Building  
Wichita, Kansas

Rice County, Sec. 21 Twp. 20 Rge. 9 (E) W (W)

Location as "NE/CNW $\frac{1}{4}$ SW $\frac{1}{4}$ " or footage from lines NE NE SE  
Lease Owner Shelley-Miller Drilling, Inc.  
Lease Name Cross Well No. 1  
Office Address 205 Miller Building, Wichita, Kansas  
Character of Well (completed as Oil, Gas or Dry Hole) Dry Hole  
Date well completed May 11 19 52  
Application for plugging filed May 11 19 52  
Application for plugging approved May 11 19 52  
Plugging commenced May 11 19 52  
Plugging completed May 11 19 52  
Reason for abandonment of well or producing formation No commercial shows  
If a producing well is abandoned, date of last production 19  
Was permission obtained from the Conservation Division or its agents before plugging was commenced? Yes

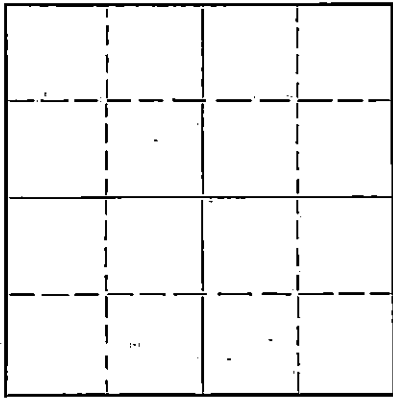

Locate well correctly on above Section Plat

Name of Conservation Agent who supervised plugging of this well Mr. Durkee  
Producing formation \_\_\_\_\_ Depth to top \_\_\_\_\_ Bottom \_\_\_\_\_ Total Depth of Well 3260 Feet  
Show depth and thickness of all water, oil and gas formations.

OIL, GAS OR WATER RECORDS

CASING RECORD

Formation	Content	From	To	Size	Put In	Pulled Out
				8 5/8"	161'	

Describe in detail the manner in which the well was plugged, indicating where the mud fluid was placed and the method or methods used in introducing it into the hole. If cement or other plugs were used, state the character of same and depth placed, from \_\_\_\_\_ feet to \_\_\_\_\_ feet for each plug set.

Plug #1 set at 150 ft., 15 sacks cement  
Plug #2 set at 30 ft., cement to top

RECEIVED  
STATE CORPORATION COMMISSION

MAY 14 1952

5-14-52

Name of Plugging Contractor CONSERVATION  
Address Wichita, Kansas

STATE OF Kansas, COUNTY OF Sedgwick, ss.  
Richard A. Shelley, President of (employee of owner or tower operator) of the above-described well, being first duly sworn on oath, says: That I have knowledge of the facts, statements, and matters herein contained and the log of the above-described well as filed and that the same are true and correct. So help me God.

(Signature) Richard A. Shelley  
205 Miller Building, Wichita, Kansas  
(Address)

SUBSCRIBED AND SWORN to before me this 13th day of May 19 52

James C. Ruge  
Notary Public.

My commission expires April 16, 1956

PLUGGING  
FILE SEC 21 Twp 20 Rge W  
BACK PAGE 15 LINE 40

159 03101 0000

COMPANY: SHELLEY-MILLER DRILLING, INC.  
205 Miller Building  
Wichita 2, Kansas

Rotary Drilling Commenced: 4-30-52  
Rotary Drilling Completed: 5-11-52

LOCATION: Cross #1 NE NE SE  
Sec. 21-20S-9W, Rice County, Kansas

CONTRACTOR: Shelley-Miller Drilling, Inc.  
Wichita, Kansas

CASING RECORD: 8 5/8" #24 Smls. Casing, set at 161', cemented with  
115 sacks cement in a 12 1/4" hole.

LOG

(Figures indicate bottom formation - measurements from top rotary bushing)

Sand and Shale	160
Red Bed	300
Anhydrite	330
Shale and Shells	440
Lime and Shale	855
Shale and Shells	1210
Lime	1225
Shale and Shells	1385
Lime and Shale	1465
Shale and Lime	1586
Lime	1815
Lime and shale	2040
Shale and Shells	2200
Shells, Shale and Lime	2320
Lime and Shale	2400
Lime	2500
Lime and Shells	2580
Lime and Shale	2660
Lime	2775
Lime and Shale	2880
Lime	2940
Lime and Shale	2990
Lime	3225
Conglomerate	3260

RECEIVED  
STATE CORPORATION COMMISSION  
MAY 15 1952  
CONSERVATION DIVISION  
Wichita, Kansas

Rotary T. D.

The undersigned, Richard A. Shelley, President of Shelley-Miller Drilling, Inc., hereby certifies in behalf of said company, that the above log is a true and correct log of the formation encountered in drilling the above well as reflected by the Daily Drilling Reports.

SHELLEY-MILLER DRILLING, INC.

By Richard A. Shelley  
President

STATE OF KANSAS )  
COUNTY OF SEDGWICK ) ss:

BE IT REMEMBERED that on this 14th day of May, 1952, before me, the undersigned, a Notary Public, duly commissioned, in and for the county and state aforesaid, came Richard A. Shelley, President, and known to me to be the same person who executed the foregoing instrument of writing in behalf of Shelley-Miller Drilling, Inc., as President of said company, and he duly acknowledged the execution of the same for himself and for said Company.

IN WITNESS WHEREOF, I have hereunto set my hand and official seal on the day and year last above written.

James C. Rouze  
Notary Public

My commission expires:

April 16, 1956