


STATE OF KANSAS
STATE CORPORATION COMMISSION

Give All Information Completely
Make Required Affidavit
Mail or Deliver Report to:
Conservation Division
State Corporation Commission
211 No. Broadway
Wichita, Kansas

WELL PLUGGING RECORD

Rice County. Sec. 21 Twp. 20 Rge. 9 W (E) (W)
Location as "NE/CNW&SW" or footage from lines SW / NW / NE
Lease Owner Frank Jones
Lease Name Dick Lease Well No. I
Office Address Mc Pherson, Kansas
Character of Well (completed as Oil, Gas or Dry Hole) ### Dry Hole
Date well completed Oct. 15 1962
Application for plugging filed February 1963
Application for plugging approved February 1963
Plugging commenced Feb 24 1963
Plugging completed Feb 27 1963
Reason for abandonment of well or producing formation Dry hole.

NORTH

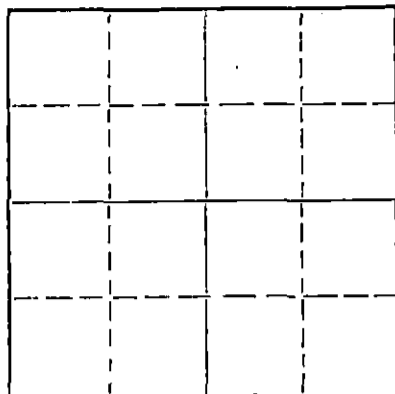

Locate well correctly on above
Section Plat

If a producing well is abandoned, date of last production 19
Was permission obtained from the Conservation Division or its agents before plugging was commenced? Yes

Name of Conservation Agent who supervised plugging of this well Gilbert Toman
Producing formation _____ Depth to top _____ Bottom _____ Total Depth of Well 3282' Feet
Show depth and thickness of all water, oil and gas formations.

OIL, GAS OR WATER RECORDS

CASING RECORD

FORMATION	CONTENT	FROM	TO	SIZE	PUT IN	PULLED OUT
				5 1/2"		2,670'

Describe in detail the manner in which the well was plugged, indicating where the mud fluid was placed and the method or methods used in introducing it into the hole. If cement or other plugs were used, state the character of same and depth placed, from _____ feet to _____ feet for each plug set.

Plugged off bottom of hole with rock. Rock from 2980', to 2970'. Dumped 5 sx of cement. Mudded hole to 180'. Made 10' of rock bridge. Dumped 20 sx of cement. Mudded hole to 35'. Made 5' of rock bridge. Dumped 10 sx of cement, filling to the bottom of the celler.

RECEIVED
STATE CORPORATION COMMISSION

MAR 11 1963

CONSERVATION DIVISION
Wichita, Kansas

(If additional description is necessary, use BACK of this sheet)

Name of Plugging Contractor Art Lamb Casing Pulling Co.
Address P.O. Box 983 Hutchinson, Kansas

STATE OF Kansas, COUNTY OF Reno, ss.
Art Lamb (employee of owner) or (owner or operator) of the above-described

well, being first duly sworn on oath, says: That I have knowledge of the facts, statements, and matters herein contained and the log of the above-described well as filed and that the same are true and correct. So help me God.


(Signature) [Signature]
2809 Kings Dr. Hutchinson, Kansas
(Address)

SUBSCRIBED AND SWORN to before me this 28 th day of February, 1963

My commission expires January 5, 1966

Notary Public.



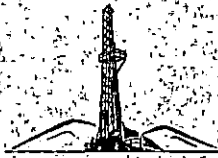

Blackstone Drilling, Inc.

P. O. BOX 455 • PHONE CH 1-1250

McPHERSON • KANSAS

October 16, 1962

COMPANY: FRANK JONES
 CONTRACTOR: BLACKSTONE DRILLING, INC.
 FARM: # DICK, EST #1
 LOCATION: SW NW NE, Sec. 21-20-24,
 Rice County, Kansas
 COMMENCED: October 8, 1962
 COMPLETED: October 15, 1962
 ELEVATION: 1741 K. B.

RECEIVED
 STATE CORPORATION COMMISSION
 FEB 5 1963
 CONSERVATION DIVISION
 Wichita, Kansas

0	to	50	Clay
50	to	115	Sand
115	to	1490	Shale and Shells
1490	to	2505	Lime and Shale
2505	to	3185	Lime
3185	to	3255	Lime and Shale
3255	to	3274	Shale
3274	to	3282½	Arbuckle Lime
3282½	to	T. D.

Cut 12" in hole to 182 ft., and run 184 ft. of 8 5/8 in. Surface Pipe. Cemented with 130 sacks cement and 4 sacks Calcium Chloride. Cut 7 7/8 in. hole to 3282½ ft. Run 3286 ft. of 5½ in. casing and cemented on bottom at 3282½ with 100 sacks cement. Plug down at 2:00 A. M. October 15, 1962.

TOPS: Brown Lime - 2909' Kansas City - 2933' Arbuckle - 3274'

Measurements taken from K. B.

I, H. J. Plouffe, President of Blackstone Drilling, Inc., do hereby certify that the above and foregoing is a true and correct copy of log on the J. Dick, Jr. # 1, located on Sec. 21-20-2W., Rice County, Kansas as reflected by the files of the Blackstone Drilling, Inc.

H. J. Plouffe
 H. J. Plouffe, President

Subscribed and sworn to before me a Notary Public, within and for McPherson County, Kansas this 17th day of October, 1962.

Ruth McVay
 Ruth McVay - Notary Public

My Commission Expires: 12/18/65