


STATE OF KANSAS
STATE CORPORATION COMMISSION

WELL PLUGGING RECORD

Give All Information Completely
Make Required Affidavit
Mail or Deliver Report to:
Conservation Division
State Corporation Commission
211 No. Broadway
Wichita, Kansas

Rice County. Sec. 21 Twp. 20 Rge. (E) 9 (W)
Location as "NE/CNW/SW" or footage from lines NE NW NE
Lease Owner Donald T. Ingling et al
Lease Name Dick Well No. 1
Office Address Wichita, Kansas
Character of Well (completed as Oil, Gas or Dry Hole) Dry Hole
Date well completed June 25, 19 65
Application for plugging filed June 25, 19 65
Application for plugging approved June 25, 19 65
Plugging commenced June 25, 19 65
Plugging completed June 25, 19 65
Reason for abandonment of well or producing formation dry

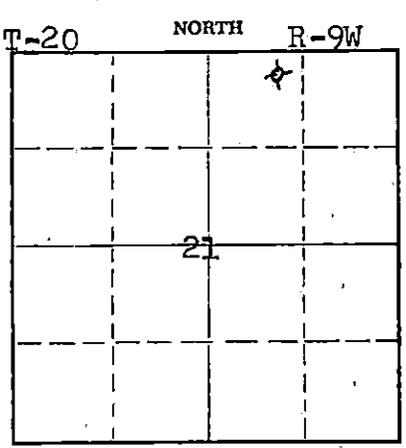

Locate well correctly on above Section Plot

If a producing well is abandoned, date of last production 19
Was permission obtained from the Conservation Division or its agents before plugging was commenced? Yes

Name of Conservation Agent who supervised plugging of this well Gilbert Toman
Producing formation _____ Depth to top _____ Bottom _____ Total Depth of Well 3300 Feet
Show depth and thickness of all water, oil and gas formations.

OIL, GAS OR WATER RECORDS

CASING RECORD

FORMATION	CONTENT	FROM	TO	SIZE	PUT IN	PULLED OUT
				8 5/8"	210'	none

Describe in detail the manner in which the well was plugged, indicating where the mud fluid was placed and the method or methods used in introducing it into the hole. If cement or other plugs were used, state the character of same and depth placed, from _____ feet to _____ feet for each plug set.

Put bottom plug at 200 feet 1/2 sack hulls and plug 20 sacks cement - fill to 40 feet with mud 1/4 sack hulls and plug - 8 sacks cement - 2 sacks cement in rathole.

RECEIVED
STATE CORPORATION COMMISSION

JUN 30 1965 6-30-65

(If additional description is necessary, use BACK of this sheet)
Name of Plugging Contractor Donald T. Ingling
Address Wichita, Kansas

CONSERVATION DIVISION
Wichita, Kansas

STATE OF KANSAS, COUNTY OF SEDGWICK, ss.
D. T. Ingling (employee of owner) or (owner or operator) of the above-described well, being first duly sworn on oath, says: That I have knowledge of the facts, statements, and matters herein contained and the log of the above-described well as filed and that the same are true and correct. So help me God.

(Signature) [Signature]
615 First National Bldg., Wichita
(Address)

SUBSCRIBED AND SWORN to before me this 28th day of June 19 65
[Signature]
Notary Public.

My commission expires Feb. 27, 1968

Donald T. Ingling et al, Lease Owner

Section 21-20-9W

Donald T. Ingling, Contractor

Location: NE NW NE

Commenced: 6-13-65
Completed: 6-25-65

County: Rice

Total Depth: 3300'

Production:

Casing: 8 5/8" 210' (125 sacks cement)

Elevation: 1739 RB

Figures below indicate bottom formation

- 140 surface clay and shale
- 210 red rock, shale and shells
- 435 shale and red bed
- 450 Anhydrite
- 865 red bed shale
- 1115 shale and salt
- 1150 shale and shells
- 1510 lime and shale
- 1535 sand
- 1540 lime
- 1685 lime
- 1885 lime and shale
- 2225 shale and lime
- 2295 lime and shale
- 2500 lime and shale
- 2585 lime
- 2725 lime
- 2810 lime and shale
- 2920 shale and lime streaks
- 2940 shale and lime streaks
- 2990 lime
- 3045 lime
- 3110 lime w/few cherty streaks
- 3180 lime
- 3225 lime
- 3284 shale
- 3300 lime
- 3300 Total Depth

RECEIVED
STATE CORPORATION COMMISSION

JUN 30 1965

CONSERVATION DIVISION
Wichita, Kansas

I certify this is a true and correct copy of the above mentioned well.

STATE OF KANSAS)
) ss.
SEDGWICK COUNTY)

Donald T. Ingling

Subscribed and sworn to before me, a Notary Public, in said county and state.

W. E. Black
Notary Public

My commission expires: Feb. 27, 1968