


15.159.19444.0000

WELL PLUGGING RECORD

Give All Information Completely
Make Required Affidavit
Mail or Deliver Report to:
Conservation Division
State Corporation Commission
P. O. Box 7027
Wichita, Kansas 67217
NORTH

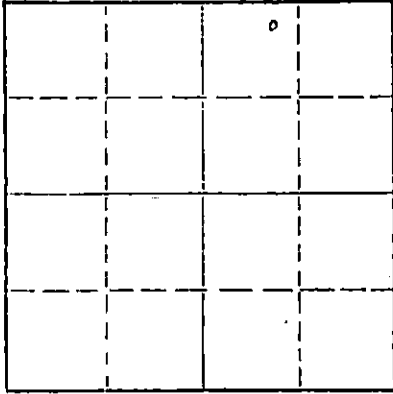

Locate well correctly on above
Section Plat

Rice County, Sec. 24 Twp. 20 Rge. (E) 9 (W)
Location as "NE/CNW/SW" or footage from lines NE NW NE
Lease Owner Frank J. Black
Lease Name Habiger Well No. 2
Office Address Box 150, McPherson, Kansas 67460
Character of Well (completed as Oil, Gas or Dry Hole) oil
Date well completed October 19 19 64
Application for plugging filed 19
Application for plugging approved 19
Plugging commenced September 1 19 73
Plugging completed September 15 19 73
Reason for abandonment of well or producing formation depleted

If a producing well is abandoned, date of last production 19
Was permission obtained from the Conservation Division or its agents before plugging was commenced? YES

Name of Conservation Agent who supervised plugging of this well Hugh Scott
Producing formation Depth to top Bottom Total Depth of Well 3359 Feet
Show depth and thickness of all water, oil and gas formations.

OIL, GAS OR WATER RECORDS

CASING RECORD

FORMATION	CONTENT	FROM	TO	SIZE	PUT IN	PULLED OUT
		0	217'	8 5/8"	217'	none
			3358'	4 1/2"	3358'	2844.02

Describe in detail the manner in which the well was plugged, indicating where the mud fluid was placed and the method or methods used in introducing it into the hole. If cement or other plugs were used, state the character of same and depth placed, from feet to feet for each plug set.

Sanded back to 3300' and dumped 4 sacks of cement.

Allied Cementing Company plugged well pumping in 3 sacks of hulls, 20 sacks of gel and 80 sacks of cement.

RECEIVED
STATE CORPORATION COMMISSION

SEPT 9 1973 9-19-73

CONSERVATION DIVISION
Wichita, Kansas

Name of Plugging Contractor PIPE PULLERS, INC.
Address Box 486, Ellinwood, Kansas 67526

STATE OF KANSAS, COUNTY OF BARTON, ss.
Evelyn Roth (employee of owner) or (owner or operator) of the above-described well, being first duly sworn on oath, says: That I have knowledge of the facts, statements, and matters herein contained and the log of the above-described well as filed and that the same are true and correct. So help me God.

(Signature) Evelyn Roth
Ellinwood, Kansas (Address)

SUBSCRIBED AND SWORN to before me this 18th day of September 19 73

My commission expires Feb. 10, 1975 George A. Meyer Notary Public

WELL LOG BUREAU—KANSAS GEOLOGICAL SOCIETY
508 East Murdock, Wichita, Kansas


15 159 19444.0000
COPY

Company- CHAMPLIN OIL & REF. CO.
Farm- George Habiger No. 2

SEC. 24 T. 20 R. 9W
NE NW NE

Total Depth. 3359'
Comm. 10-13-64 Comp. 10-19-64
Shot or Treated.
Contractor. Red Tiger Drilling
Issued. 1-16-65

County Rice
KANSAS

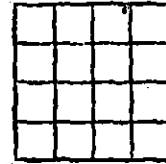

Elevation. 1664 D F

Production. PMP 101 BOPD, NW

CASING:

8 5/8" 217' cem. w/175 sx.
4 1/2" 3358' cem. w/75 sx.

Figures Indicate Bottom of Formations.

sand	65
Shale	252
Anhydrite	263
shale	1230
lime & shale	3057
lime	3359
Rotary Total Depth	

TOPS-Electric	
Heebner	2728
Brown Lime	2866
Lansing	2899
Base Kansas City	3190
Conglomerate Lime	3208
Conglomerate Sand	3260-64
Kinderhook Sand	3257-75
Kinderhook Shale	3321
Macuoketa	3355

RECEIVED
STATE CORPORATION COMMISSION

AUG 13 1973

CONSERVATION DIVISION
Wichita, Kansas