


STATE OF KANSAS  
STATE CORPORATION COMMISSION

Form CP-4

Give All Information Completely  
Make Required Affidavit  
Mail or Deliver Report to:  
Conservation Division  
State Corporation Commission  
212 No. Market  
Wichita, Kansas 67202

WELL PLUGGING RECORD

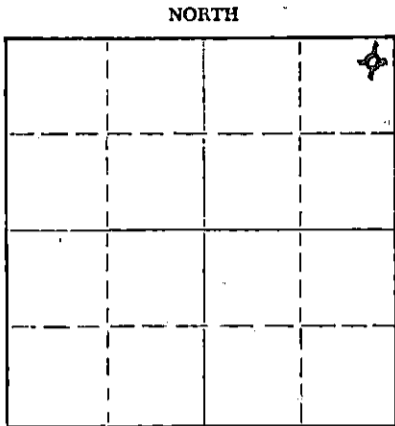

Locate well correctly on above  
Section Plat

Rice County, Sec. 24 Twp. 20S Rge. ~~22E~~ 9 (W)  
Location as "NE/CNW%SW%" or footage from lines NE NE NE

Lease Owner Champlin Petroleum Company

Lease Name Habiger Well No. 1

Office Address P. O. Box 308, Ellinwood, Kansas 67526

Character of Well (completed as Oil, Gas or Dry Hole) Oil

Date well completed September 3 19 64

Application for plugging filed October 5 19 71

Application for plugging approved October 6 19 71

Plugging commenced November 11 19 71

Plugging completed November 29 19 71

Reason for abandonment of well or producing formation Producing 100% salt water

If a producing well is abandoned, date of last production February 21 19 71

Was permission obtained from the Conservation Division or its agents before plugging was commenced? Yes

Name of Conservation Agent who supervised plugging of this well Gilbert Toman

Producing formation \_\_\_\_\_ Depth to top \_\_\_\_\_ Bottom \_\_\_\_\_ Total Depth of Well 3400 Feet

Show depth and thickness of all water, oil and gas formations.

OIL, GAS OR WATER RECORDS

CASING RECORD

FORMATION	CONTENT	FROM	TO	SIZE	PUT IN	PULLED OUT
				8 5/8" OD	217'	None
				4 1/2" OD	3376'	2700'

Describe in detail the manner in which the well was plugged, indicating where the mud fluid was placed and the method or methods used in introducing it into the hole. If cement or other plugs were used, state the character of same and depth placed, from \_\_\_\_\_ feet to \_\_\_\_\_ feet for each plug set.

Filled with sand from total depth to 3290' and dumped in 3 sacks of cement filling hole to 3260', then pumped in 20 sacks of Gel mud under pressure and pumped in 75 sacks of cement filling hole to bottom of cellar.

RECEIVED  
STATE CORPORATION COMMISSION  
DEC 2 1971  
CONSERVATION DIVISION  
Wichita, Kansas

(If additional description is necessary, use BACK of this sheet)

Name of Plugging Contractor Glenn & Smith Pipe Pulling Company

Address P. O. Box 156, Ellinwood, Kansas 67526

STATE OF Kansas, COUNTY OF Barton, ss.

J. W. Meyers (employee of owner) or (owner or operator) of the above-described

well, being first duly sworn on oath, says: That I have knowledge of the facts, statements, and matters herein contained and the log of the above-described well as filed and that the same are true and correct. So help me God.

(Signature) J. W. Meyers, District Operations Manager  
P. O. Box 308, Ellinwood, Kansas 67526  
(Address)

Subscribed and Sworn to before me this 1st day of December 19 71



N. Kenneth Starnes  
Notary Public.

DRILLERS LOG

No. 1 George Habiger

CASING RECORD: 8 5/8" @ 217' w/175 sx cement  
 4 1/2" @ 3375.95' w/75 sx cement  
 TOTAL DEPTH: 3400'

COMPANY: Champlin Oil & Ref. Co.  
 CONTRACTOR: Red Tiger Drilling Co.  
 COMMENCED: August 28, 1964  
 COMPLETED: September 1, 1964

DESCRIPTION: NE NE NE  
 24-298-9W  
 Rice Co., Kansas  
 ELEVATION: 1670 DF  
 1673 RB

<u>FORMATION</u>	<u>FROM</u>	<u>TO</u>	<u>REMARKS</u>
Clay	0	5	
Sand	5	65	
Sand & Shale	65	175	
Shale & Red Bed	175	217	
Red Bed	217	249	
Anhydrite	249	261	
Shale, Shells & Salt	261	1070	
Shale & Shells	1070	1440	
Lime & Shale	1440	1925	
Shale & Shells	1925	2475	
Lime	2475	2740	
Shale	2740	2870	
Lime	2870	3195	
Lime & Shale	3195	3285	
Conglomerate	3285	3294	
Sand	3294	3305	
Shale	3305	3392	
Lime	3392	3400	

RECEIVED  
 STATE CORPORATION COMMISSION  
 OCT 6 1971  
 CONSERVATION DIVISION  
 Wichita, Kansas

I certify that this is a true and correct copy of the above log to the best of my knowledge.

RED TIGER DRILLING COMPANY

*George A. Angle*  
 George A. Angle

Subscribed and sworn to before me this 2nd day of September, 1964.

*D. Daniel J. Head*  
 Notary Public

My Commission Expires:  
11-17-66