


STATE OF KANSAS
STATE CORPORATION COMMISSION

WELL PLUGGING RECORD

Give All Information Completely
Make Required Affidavit
Mail or Deliver Report to
Conservation Division
State Corporation Comm.
245 North Water
Wichita, KS 67202

Rice County. Sec. 24 Twp. 20 Rge. 9 E/W
Location as "NE/CNW $\frac{1}{2}$ SW $\frac{1}{2}$ " or footage from lines
NW NE NE.

Lease Owner Petroleum Energy, Inc.
Lease Name Habiger A#1 Well No. _____
Office Address Wichita, Kansas 67202
Character of Well (Completed as Oil, Gas or Dry Hole) _____

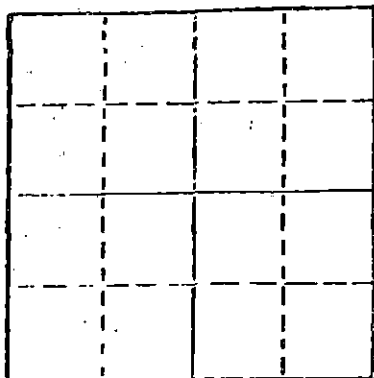

Locate well correctly on above
Section Plat

Date Well completed _____ 19____
Application for plugging filed _____ 19____
Application for plugging approved _____ 19____
Plugging commenced 6/7/80 _____ 19____
Plugging completed 6/10/80 _____ 19____
Reason for abandonment of well or producing formation
depleted.
If a producing well is abandoned, date of last production _____ 19____

Was permission obtained from the Conservation Division or
its agents before plugging was commenced? yes

Name of Conservation Agent who supervised plugging of this well Toman
Producing formation _____ Depth to top _____ Bottom _____ Total Depth of Well 3344
Show depth and thickness of all water, oil and gas formations.

OIL, GAS OR WATER RECORDS

CASING RECORD

FORMATION	CONTENT	FROM	TO	SIZE	PUT IN	PULLED OUT
				8-5/8	214	none
				4 1/2"	3243	2640'

Describe in detail the manner in which the well was plugged, indicating where the mud fluid
was placed and the method or methods used in introducing it into the hold. If cement or other
plugs were used, state the character of same and depth placed, from _____ feet to
_____ feet for each plug set.

Sanded to 3200' and ran 4 sacks cement. Loaded hole, shot pipe at 2630',
pulled 69 joints. Pumped 3 sacks hulls, 20 sacks gel, 85 sacks cement, 50-50
pos, 2% gel and 8-5/8 plug.

PLUGGING COMPLETE.

RECEIVED
STATE CORPORATION COMMISSION
JUN 16 1980

(If additional description is necessary, use BACK of this sheet)

Name of Plugging Contractor KIELSO CASING PULLING
CHASE, KANSAS

STATE OF KANSAS COUNTY OF RICE, ss.
R. DARRELL KELSO (employee of owner) or (owner or operator)
of the above-described well, being first duly sworn on oath, says: That I have knowledge of
the facts, statements, and matters herein contained and the log of the above-described well
as filed and that the same are true and correct. So help me God.

(Signature) R. Darrell Kelso
CHASE, KANSAS

SUBSCRIBED AND SWORN TO before me this 12th day of June, 19 80

Margaret Melcher
Notary Public.

My commission expires



DRILLERS LOG

OPERATOR: Petroleum Energy, Inc.; Suite 710; One-Twenty Bldg.; Wichita, Ks.

CONTRACTOR: White & Ellis Drilling, Inc., Box 448, El Dorado, Kansas 67042

67202

Lease Name Habiger Well No. ~~A~~ A #1

Sec. 24 T. 20 R. 9W Spot. NW NE NE

County Rice State Kansas Elevation

Casing Record:

Surface: 8 5/8" @ 214' with 150 Sxs.

Production: @ with Sxs.

Type Well: Oil Total Depth 3344' KB

Drilling Commenced: 3/7/80 Drilling Completed 3/14/80

Formation	From	To	Tops
Cellar	0	7	
Shale, Lime	7	3344	

- 4 1/2" casing -

RECEIVED
 JUN - 5 1980
 CONSERVATION DIVISION
 Wichita, Kansas

COMPLETION RECORD

Liner Record: Size From To

Cementing Record: Sacks

Perforating Record:

Formation	Perforated Interval	Number Shots

Initial Production:

Electric Log	Type and Depths Covered