

STATE OF KANSAS
STATE CORPORATION COMMISSION

Give All Information Completely
Make Required Affidavit
Mail or Deliver Report to:
Conservation Division
State Corporation Commission
212 No. Market
Wichita, Kansas

WELL PLUGGING RECORD

Rice County, Sec. 24 Twp. 20S Rge. ~~E~~ 9 (W)

Location as "NE/CNW/SE" or footage from lines SE SE NE

Lease Owner Champlin Petroleum Company

Lease Name Habiger Well No. 4

Office Address P. O. Box 308, Ellinwood, Kansas 67526

Character of Well (completed as Oil, Gas or Dry Hole) Oil

Date well completed March 11 19 65

Application for plugging filed October 5 19 71

Application for plugging approved October 6 19 71


Plugging commenced November 23 19 71

Plugging completed November 29 19 71

Reason for abandonment of well or producing formation Producing 100% salt water

If a producing well is abandoned, date of last production March 22 19 71

Was permission obtained from the Conservation Division or its agents before plugging was commenced? Yes

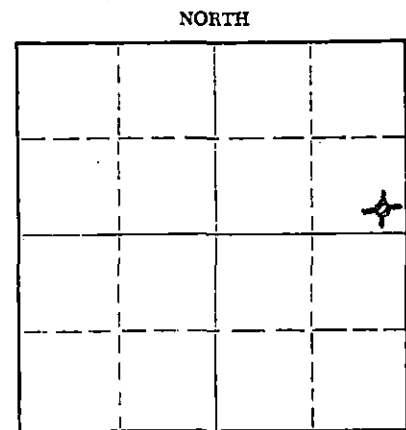

Locate well correctly on above Section Plat

Name of Conservation Agent who supervised plugging of this well Gilbert Toman

Producing formation _____ Depth to top _____ Bottom _____ Total Depth of Well 3380 Feet

Show depth and thickness of all water, oil and gas formations.

OIL, GAS OR WATER RECORDS

CASING RECORD

FORMATION	CONTENT	FROM	TO	SIZE	PUT IN	PULLED OUT
				8 5/8" OD	210'	None
				4 1/2" OD	3378'	2790'

Describe in detail the manner in which the well was plugged, indicating where the mud fluid was placed and the method or methods used in introducing it into the hole. If cement or other plugs were used, state the character of same and depth placed, from _____ feet to _____ feet for each plug set.

Filled with sand from total depth to 3250' and dumped in 3 sacks of cement filling hole to 3220', then pumped in 20 sacks of Gel mud under pressure and pumped in 75 sacks of cement filling hole to bottom of cellar.

RECEIVED
STATE CORPORATION COMMISSION
DEC 2 1971
CONSERVATION DIVISION
Wichita, Kansas


(If additional description is necessary, use BACK of this sheet)
Name of Plugging Contractor Glenn & Smith Pipe Pulling Company
Address P. O. Box 156, Ellinwood, Kansas 67526

STATE OF Kansas, COUNTY OF Barton, ss.
J. W. Meyers (employee of owner) or (owner or operator) of the above-described well, being first duly sworn on oath, says: That I have knowledge of the facts, statements, and matters herein contained and the log of the above-described well as filed and that the same are true and correct. So help me God.

(Signature) *J. W. Meyers*
J. W. Meyers, District Operations Manager
P. O. Box 308, Ellinwood, Kansas 67526
(Address)

Subscribed and sworn to before me this 1st day of December, 19 71

My commission expires 4/16/74

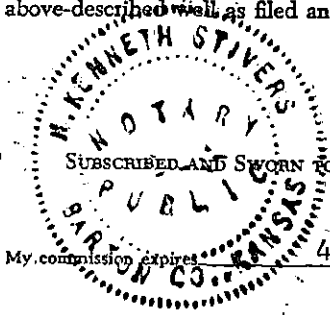

Notary Public.

DRILLERS LOG

George Habiger #4

CASING RECORD:	COMPANY:	Champlin Petroleum Co.	DESCRIPTION:
8 5/8" @ 209.62'	CONTRACTOR:	Red Tiger Drilling Co.	SE SE NE
w/215 sx cement	COMMENCED:	February 21, 1965	24-20S-9W
4 1/2" @ 3378.20'	COMPLETED:	February 27, 1965	Rice Co., Kansas
w/75 sx cement			ELEVATION:
TOTAL DEPTH: 3380'			

<u>FORMATION</u>	<u>FROM</u>	<u>TO</u>	<u>REMARKS</u>
Sand & Clay	0	140	
Gravel	140	165	
Redbed	165	211	
Shale & Redbed	211	254	
Anhydrite	254	266	
Shale & Shells	266	1125	
Lime & Shale	1125	2525	
Lime	2525	2734	
Shale	2734	2738	
Lime & Shale	2738	2895	
Lime	2895	3300	
Sand & Shale	3300	3380	

RECEIVED
 STATE CORPORATION COMMISSION
 OCT 6 1971
 CONSERVATION DIVISION
 Wichita, Kansas

I certify that this is a true and correct copy of the above log to the best of my knowledge.

RED TIGER DRILLING COMPANY

Maxine V. Head
 Maxine V. Head

Subscribed and sworn to before me this 1st day of March, 1965.

Jean Holland
 Notary Public

My Commission Expires:

5-22-66