

STATE OF KANSAS  
STATE CORPORATION COMMISSION


Form CP-4

Give All Information Completely  
Make Required Affidavit  
Mail or Deliver Report to:  
Conservation Division  
State Corporation Commission  
212 No. Market  
Wichita, Kansas 67202

WELL PLUGGING RECORD

Rice County. Sec. 24 Twp. 20 Rge. 9 (E) (W)  
SE SW SW

Location as "NE/CNW/SW" or footage from lines \_\_\_\_\_  
Lease Owner Thunderbird Drilling, Inc.  
Lease Name Seitz #3 Well No. \_\_\_\_\_  
Office Address Wichita, Kansas 67202  
Character of Well (completed as Oil, Gas or Dry Hole) \_\_\_\_\_  
Date well completed \_\_\_\_\_ 19\_\_\_\_  
Application for plugging filed \_\_\_\_\_ 19\_\_\_\_  
Application for plugging approved \_\_\_\_\_ 19\_\_\_\_  
Plugging commenced 11/12/71 \_\_\_\_\_ 19\_\_\_\_  
Plugging completed 11/23/71 \_\_\_\_\_ 19\_\_\_\_  
Reason for abandonment of well or producing formation depleted.

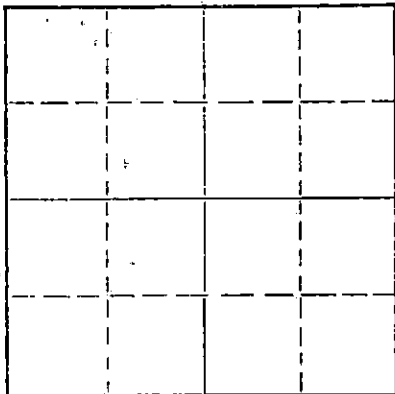

Locate well correctly on above  
Section Plat

If a producing well is abandoned, date of last production \_\_\_\_\_ 19\_\_\_\_  
Was permission obtained from the Conservation Division or its agents before plugging was commenced? yes

Name of Conservation Agent who supervised plugging of this well Toman  
Producing formation \_\_\_\_\_ Depth to top \_\_\_\_\_ Bottom \_\_\_\_\_ Total Depth of Well 3365 Feet  
Show depth and thickness of all water, oil and gas formations.

OIL, GAS OR WATER RECORDS

CASING RECORD

FORMATION	CONTENT	FROM	TO	SIZE	PUT IN	PULLED OUT
				8-5/8	204	none
				5 1/2"	3360	2381'

Describe in detail the manner in which the well was plugged, indicating where the mud fluid was placed and the method or methods used in introducing it into the hole. If cement or other plugs were used, state the character of same and depth placed, from \_\_\_\_\_ feet to \_\_\_\_\_ feet for each plug set.

Checked hole to 3365', ran sand to 3350' and dumped 5 sacks of cement. Shot pipe at 2600', 2506', 2416', 2390', 2375', pulled 81 joints. Allied pumped 3 sacks hulls, 20 sacks mud and 75 sacks of cement.

PLUGGING COMPLETE.

RECEIVED  
STATE CORPORATION COMMISSION  
NOV 30 1971  
CONSERVATION DIVISION  
Wichita, Kansas

(If additional description is necessary, use BACK of this sheet)  
Name of Plugging Contractor: KNIGHT CASING PULLING CO., INC.  
Address: CHASE, KANSAS

STATE OF KANSAS, COUNTY OF RICE, ss. NOEL J. KNIGHT

(employee of owner) or (owner or operator) of the above-described well, being first duly sworn on oath, says: That I have knowledge of the facts, statements, and matters herein contained and the log of the above-described well as filed and that the same are true and correct. So help me God.

(Signature) Noel Knight  
CHASE, KANSAS  
(Address)

Subscribed and Sworn to before me this 24th day of November, 19 71

My commission expires Feb. 15, 1975  
MARGARET MELCHER  
NOTARY PUBLIC  
Rice County, Kansas

Margaret Melcher  
Notary Public.