


STATE OF KANSAS
STATE CORPORATION COMMISSION

Give All Information Completely
Make Required Affidavit
Mail or Deliver Report to:
Conservation Division
State Corporation Commission
800 Bitting Building
Wichita, Kansas

WELL PLUGGING RECORD

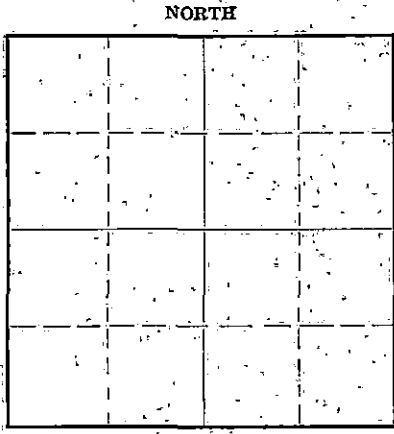

Barton County, Sec. 31 Twp. 20 Rge. 15 (W)
Location as "NE/CNW 1/4 SW 1/4" or footage from lines NE NW SW
Lease Owner Anderson-Prichard Oil Corporation
Lease Name Spreier Well No. 1
Office Address Box 142 - Great Bend, Kansas
Character of Well (completed as Oil, Gas or Dry Hole) Oil
Date well completed Dec. 22, 19 47
Application for plugging filed Sept. 1, 19 51
Application for plugging approved Sept. 4, 19 51
Plugging commenced Sept. 4, 19 51
Plugging completed Sept. 8, 19 51
Reason for abandonment of well or producing formation Non-Commercial

If a producing well is abandoned, date of last production July 16, 19 51
Was permission obtained from the Conservation Division or its agents before plugging was commenced? Yes

Name of Conservation Agent who supervised plugging of this well C. D. Stough
Producing formation Arbuckle Depth to top 3753 Bottom Total Depth of Well 3804 Feet
Show depth and thickness of all water, oil and gas formations.

OIL, GAS OR WATER RECORDS

CASING RECORD

Formation	Content	From	To	Size	Put In	Pulled Out
				8-5/8	997'	None
				5-1/2	3800'	3190'

Describe in detail the manner in which the well was plugged, indicating where the mud fluid was placed and the method or methods used in introducing it into the hole. If cement or other plugs were used, state the character of same and depth placed, from feet to feet for each plug set.

Plugged back from TD 3804' w/crushed rock & 5 sax cement to 3780'
Shot casing off at 3190' - Pulled Casing
Filled hole with heavy mud to 235'
Set rock bridge and dumped 15 sax cement
Filled hole with heavy mud to 35' from top
Mixed 15 sax cement for cap on well

(If additional description is necessary, use BACK of this sheet)

Correspondence regarding this well should be addressed to W. J. Dearen % Anderson-Prichard Oil Corporation
Address Box 142 - Great Bend, Kansas

STATE OF KANSAS, COUNTY OF BARTON, ss.
Gerald M. Dougherty (employee of owner) or (owner or operator) of the above-described well,
being first duly sworn on oath, says: That I have knowledge of the facts, statements, and matters herein contained and the log of the above-described well as filed and that the same are true and correct. So help me God.

(Signature) Gerald M. Dougherty
Box 142 - Great Bend, Kansas
(Address)

SUBSCRIBED AND SWORN to before me this 21st. day of September, 1951

My commission expires December 4, 1954

Virdella M. Spink
Notary Public.

PLUGGING
FILE SEC 31 T 20 R 15 S
BOOK PAGE 107 LINE 4

SEP 24 1951
WICHITA, KANSAS
9-24-1951

SPREIER WELL # 1

Location: Approx. Ctr. NE $\frac{1}{4}$ NW $\frac{1}{4}$ SW $\frac{1}{4}$ Sec. 31-208-15W Date Spudded: 11-8-47
 Barton County, Kansas

Operator: The Bay Petroleum Corporation Oil String Cemented: 11-24-47

Contractor: H H & B Company Total Depth: 3803'

Elevation: 1989 DF
 1991 KB

Casing Record: Surface: 32 jts. 28 $\frac{1}{2}$ " 8-5/8" cemented
 @ 999.33' w/325 sacks bulk
 Oil String: 122 jts. 5-1/2" OD 14 $\frac{1}{2}$ " Top Anhydrite: 993
 8 RT Republic H-40 New " Arbuckle: 3752 (-1761)
 cemented @ 3800', 1' off bottom
 w/125 sacks bulk cement.

L O G

(Figures indicate bottom of formation)

Clay and shale	0 to 125
Shale	410
Sand, shale and red bed	665
Red bed and shale	993
Anhydrite	1000
Red bed and shale	1255
Red bed, shale and lime	1560
Shale, salt and shells	1820
Lime and shale	2345
Sand and lime, shale	2435
Shale and shells	2565
Lime and shale	2965
Sand, lime and shale	3045
Broken lime	3155
Shale and lime, salt	3210
Lime and shale	3395
Lime, shale and shells	3450
Shale and lime	3545
Lime, shale and shells	3580
Shale and lime	3740
Shale and lime shells	3785
Lime and shale	3803
Total Depth	3803

The undersigned, H H & B COMPANY; hereby certifies that the above log is a true and correct log of the formations encountered in drilling the above noted well as reflected by the Daily Drilling Reports.

H H & B COMPANY
 BY: Richard Hendery

Subscribed and sworn to before me this 25th day of November 1947.

Richard Hendery
 Notary Public

My commission expires: July 2, 1949.

PLUGGING
 FILE SEC-31-208-15W
 BOOK PAGE 107 LINE 4