


WELL PLUGGING RECORD

Give All Information Completely
Make Required Affidavit
Mail or Deliver Report to:
Conservation Division
State Corporation Commission
800 Bitting Building
Wichita, Kansas

Barton County, Sec. 31 Twp. 20S Rge. (E) 15 (W)

Location as "NE/CNW/SW" or footage from lines SW NE NW
Lease Owner H & H Supply Company
Lease Name Gilbert Well No. 3
Office Address Box 4173, Oklahoma City, Oklahoma
Character of Well (completed as Oil, Gas or Dry Hole) Oil
Date well completed November 22, 1947 19
Application for plugging filed September 17, 1953 19
Application for plugging approved September 18, 1953 19
Plugging commenced September 28, 19 53
Plugging completed October 4, 1953 19
Reason for abandonment of well or producing formation oil depleted

NORTH

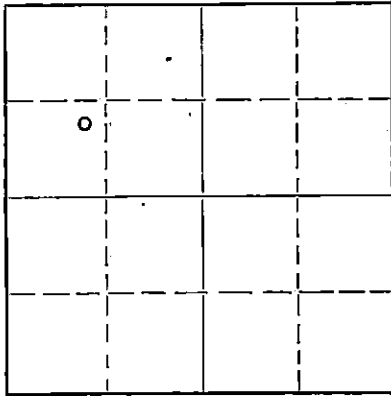

Locate well correctly on above
Section Plat

If a producing well is abandoned, date of last production 19
Was permission obtained from the Conservation Division or its agents before plugging was commenced? Yes

Name of Conservation Agent who supervised plugging of this well C. D. Stough
Producing formation _____ Depth to top _____ Bottom _____ Total Depth of Well 3834 Feet
Show depth and thickness of all water, oil and gas formations.

OIL, GAS OR WATER RECORDS

CASING RECORD

FORMATION	CONTENT	FROM	TO	SIZE	PUT IN	PULLED OUT
				8-5/8"	1022'	
				5-1/2"	3829'	2400'

Describe in detail the manner in which the well was plugged, indicating where the mud fluid was placed and the method or methods used in introducing it into the hole. If cement or other plugs were used, state the character of same and depth placed, from _____ feet to _____ feet for each plug set.

Measured in to total depth - 3834' - put in 20' rock and dumped 5 sacks
cement. Shot casing off at 2400' - pulled pipe out of hole.
Squeezed surface casing with 30 sacks mud and 100 sacks cement.
Work started 9-28-53; completed 10-4-53.

CONSERVATION DIVISION
Wichita, Kansas

11-24-1953
RECEIVED
NOV 17 1953
H. H. Supply Co.

(If additional description is necessary, use BACK of this sheet)

Name of Plugging Contractor _____
Address _____

STATE OF Oklahoma COUNTY OF Oklahoma, ss.
Bernard Shanker (employee of owner) or (owner or operator) of the above-described well, being first duly sworn on oath, says: That I have knowledge of the facts, statements, and matters herein contained and the log of the above-described well as filed and that the same are true and correct. So help me God.

ATTEST: Bernard Shanker (Signature)
Sec. & Treas.

P.O. Box 4173, Oklahoma City, Okla.
(Address)

SUBSCRIBED AND SWORN TO before me this 23 day of October, 19 53

E. R. (Jack) Smith
Notary Public.

My commission expires October 22, 1956

PLUGGING
FILE SEC 31 T 20 R 15W
BOOK PAGE 129 LINE 34

Casement 11-8-47
Casing 12-15-47

GILBERT WELL # 3

Location: Approx. Ctr. SW NE NW Sec. 31-208-15W Date Spudded: 11-8-47
 Operators: The Bay Petroleum Corporation Oil String Cemented: 11-22-47
 Contractor: H H & B Company Total Depth: 3833' (-1815)
 Casing Record: Surfaces: 33 jts. or 1022' 8-5/8" Elevation: 2018 DF
 8 RT 28# new casing cemented 2020 KB
 @ 1022' w/325 sacks Monarch.
 Oil String: 124 jts. 5 1/2" OD 14# Top Anhydrite: 1015' (-1002)
 8 RT Republic H-40 new casing K.C. 3447 (-1229)
 cemented @ 3829 DF or 2' off " Arbuckle: 3777' (-1757)
 bottom w/125 sacks.

L O G

(Figures indicate bottom of formation)

Clay and sand	0 to	100
Shale		170
Shale and shells		425
Dakota Sand		567
Red bed		610
Shale and shells		980
Shale		1015
Anhydrite		1045
Shale		1425
Shale and salt		1625
Shale and shells		1916
Shale and lime		2495
Shale		2630
Shale and lime		3035
Lime and shale		3235
Lime		3510
Lime broken		3563
Lime		3660
Lime and shale		3770
Lime		3819
Arbuckle lime		3833
Total Depth		3833

Lat. 3027-31, open 7" 20m87
 15' clean well dip. COTD
 500' acid
 fluid three 1/2" choke
 32' depth from 8' lower

The undersigned, H H & B COMPANY, hereby certifies that the above log is a true and correct log of the formations encountered in drilling the above noted well as reflected by the Daily Drilling Reports.

H H & B COMPANY

BY: Richard Henders

Subscribed and sworn to before me this 24th day of November 1947

Richard Henders
Notary Public

My commission expires: July 2, 1949.

PLUGGING
 FILE SEC 31-T 20 R 15-40
 BOOK PAGE 129 LINE 34

RECEIVED
 STATE CORPORATIONS

CONCEA