


WELL PLUGGING RECORD

Give All Information Completely
Make Required Affidavit
Mail or Deliver Report to:
Conservation Division
State Corporation Commission
800 Biting Building
Wichita, Kansas

Barton County. Sec. 31 Twp. 20S Rge. (E) 15W
Location as "NE/CNW/SW" or footage from lines NE SW NW
Lease Owner H & H Supply Company
Lease Name Gilbert Well No. 4
Office Address Box 4173, Oklahoma City, Oklahoma
Character of Well (completed as Oil, Gas or Dry Hole) Oil
Date well completed July, 1948 19
Application for plugging filed September 17, 1953 19
Application for plugging approved September 18, 1953 19
Plugging commenced October 4 19 53
Plugging completed October 10, 1953 19
Reason for abandonment of well or producing formation oil depleted

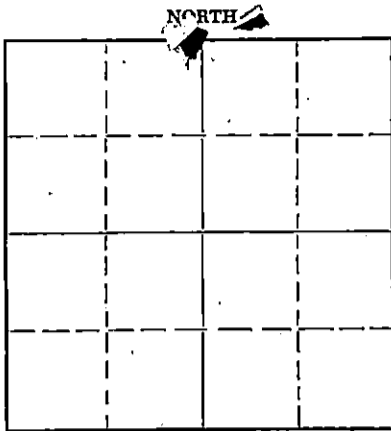

Locate well correctly on above
Section Plat

If a producing well is abandoned, date of last production _____ 19____
Was permission obtained from the Conservation Division or its agents before plugging was commenced? Yes

Name of Conservation Agent who supervised plugging of this well C. D. Stough
Producing formation _____ Depth to top _____ Bottom _____ Total Depth of Well 3816 Feet
Show depth and thickness of all water, oil and gas formations.

OIL, GAS OR WATER RECORDS

CASING RECORD

FORMATION	CONTENT	FROM	TO	SIZE	PUT IN	PULLED OUT
				8-5/8"	994'	
				5-1/2"	3813'	2300'

Describe in detail the manner in which the well was plugged, indicating where the mud fluid was placed and the method or methods used in introducing it into the hole. If cement or other plugs were used, state the character of same and depth placed, from _____ feet to _____ feet for each plug set.

Measured in to total depth - put in 40' rock & 5 sacks cement.

Shot off casing at 2300' - pulled pipe out of hole, Squeezed surface casing with 30 sacks mud and 100 sacks cement.

Work started 10-4-53; work completed 10-10-53.

CONS. DIVISION
WICHITA, KANSAS

11-24-1953
RECEIVED
NOV 12 1953
H. & H. SUPPLY CO.

(If additional description is necessary, use BACK of this sheet)
Name of Plugging Contractor _____
Address _____

STATE OF Oklahoma, COUNTY OF Oklahoma, ss.
Bernard Shanber (employee of owner) or (owner or operator) of the above-described well, being first duly sworn on oath, says: That I have knowledge of the facts, statements, and matters herein contained and the log of the above-described well as filed and that the same are true and correct. So help me God.

ATTEST: Bernard Shanber (Signature)
Sec. & Treas. P.O. Box, 4173, Oklahoma City, Okla.
(Address)

SUBSCRIBED AND SWORN TO before me this 23 day of October, 19 53

My commission expires October 22, 1956

E. R. (Jack) Smith
Notary Public.

24-7368-S 3-53-20M

PLUGGING
FILE SEC 31 T 20 R 15W
BOOK PAGE 129 LINE 37

10-22-56

DRILLERS LOG OF FORMATIONS
ANDERSON-RICHARD OIL CORPORATION
Gilbert #4
C. NE/4 SW/4 NW/4 Sec. 31-20S-16W
Barton County, Kansas

<u>FORMATIONS DRILLED</u>	<u>FROM</u>	<u>DEPTH</u>	<u>TO</u>	
Clay & Sand	0		65	
Sand & Shale	65		100	
Shale, Sand & Red Bed	100		340	
Shale & Sand	340		415	
Sand	415		540	
Shale & Red Bed	540		610	
Red Bed, Shale & Shells	610		890	
Shale & Shells	890		1000	
Anhydrite	1000		1035	8-5/8" Casing set nt 994'
Shale & Shells	1035		1400	Cemented with 450 sacks
Salt & Shale	1400		1590	Cement Circulated
Shale & Shells	1590		1835	
Shale & Lime	1835		1990	
Lime	1990		2245	
Shale & Lime	2245		2555	
Shale	2555		2785	
Lime & Shale	2785		3125	
Lime	3125		3670	
Lime & Shale	3670		3750	
Shale	3750		3775	
Lime	3775		3813	5 1/2" Casing set at 3813'
				Cemented with 175 sacks
		Total Depth	3813	

CONTRACTOR: TRANSIT CORPORATION
 3111 Apco Tower
 Oklahoma City, Oklahoma

I hereby certify the foregoing to be a true and correct log of the formations encountered in the above well.

PLUGGING
 FILE SEC 31 T 20 R 15 W
 BOOK PAGE 129 LINE 37

TRANSIT CORPORATION
 By: *L. T. Young*
 L. T. Young - Asst. Secy.

Certified to before me this 6th day of July 1948

By: *Hazel Turley*
 Hazel Turley (Notary Public) My commission expires March 13, 1949.