


Give All Information Completely
Make Required Affidavit
Mail or Deliver Report to:
Conservation Division
State Corporation Commission
212 North Market, Insurance Bldg.
Wichita, Kansas

WELL PLUGGING RECORD

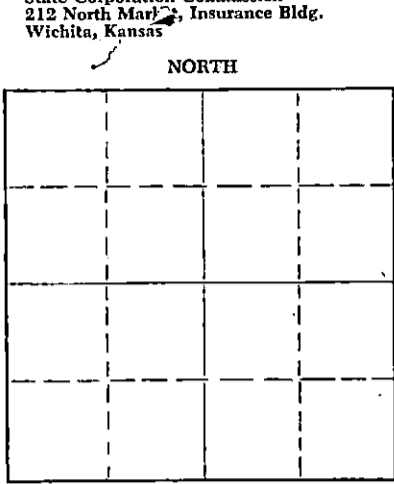

Barton County, Sec. 4 Twp. 20S Rge. 13W (E) (W)
Location as "NE/CNW/SW" or footage from lines SW 1/4 2 F
Lease Owner J. O. Forbes
Lease Name Gunn Well No. # 1
Office Address P. O. Box 221 Great Bend, Kansas
Character of Well (completed as Oil, Gas or Dry Hole) _____
Date well completed _____ 19____
Application for plugging filed yes 19____
Application for plugging approved yes 19____
Plugging commenced 3-16-61 19____
Plugging completed 3-30-61 19____
Reason for abandonment of well or producing formation _____
If a producing well is abandoned, date of last production _____ 19____
Was permission obtained from the Conservation Division or its agents before plugging was commenced? yes

Name of Conservation Agent who supervised plugging of this well Don Truan
Producing formation _____ Depth to top _____ Bottom _____ Total Depth of Well 3370' Feet
Show depth and thickness of all water, oil and gas formations.

OIL, GAS OR WATER RECORDS					CASING RECORD	
FORMATION	CONTENT	FROM	TO	SIZE	PUT IN	PULLED OUT
				5 1/2"		1822'

Describe in detail the manner in which the well was plugged, indicating where the mud fluid was placed and the method or methods used in introducing it into the hole. If cement or other plugs were used, state the character of same and depth placed, from _____ feet to _____ feet for each plug set.

Plugging commenced 3-16-61.
Plugging completed 3-30-61.
Measured in to total depth: 3370'.
Plugged off bottom:
Sanded back to 3225' and dumped 5 sacks of cement.
Worked and shot casing. Spotted 6 1/2 barrels of oil.
Worked and shot 5 1/2" casing free at 1822'.
Plugged well:
Mudded up to 300' and set 10' rock bridge at 300'.
Dumped 3 1/2 yard of ready mix cement to plug well to top.

RECEIVED
STATE CORPORATION COMMISSION
MAY 25 1961
CONSERVATION DIVISION
Wichita, Kansas

h-25-61

(If additional description is necessary, use BACK of this sheet)
Name of Plugging Contractor J. O. Forbes d/b/a Forbes Dasing Pulling Co.
Address P. O. Box 221 Great Bend, Kansas

STATE OF Kansas, COUNTY OF Barton, ss.
J. O. Forbes (employee of owner) or (owner or operator) of the above-described well, being first duly sworn on oath, says: That I have knowledge of the facts, statements, and matters herein contained and the log of the above-described well as filed and that the same are true and correct. So help me God.

(Signature) J. O. Forbes
Great Bend, Kansas
(Address)

SUBSCRIBED AND SWORN to before me this 30th day of April, 19 61

My commission expires December 8th, 1963 Kayann Jenkins Notary Public.

SCHERMERHORN OIL CORPORATION

GUNN # 1

(SESESE)

E/2 W/2 E/2 SW/4 and E/2 E/2 SW/4,
Sec. 4-20S-13W Barton County, Kansas

mirrored log

Drilling Started 4-28-55
Drilling Completed 5-9-55
8 5/8" OD casing cemented at 718'
5 1/2" OD casing cemented at 3490'

From	To	Formation	Remarks
-0'	160'	Surface soil	
160'	170'	Shale	
170'	713'	Red bed and shale	
713'	725'	Anhydrite	Ran 23 jts. 8 5/8" OD casing. Set at 718' with 425 sacks cement.
725'	940'	Red bed and shale	
940'	1450'	Shale and shells	
1450'	1564'	Shale and lime	
1564'	2075'	Lime	
2075'	2751'	Lime and shale	
2751'	3085'	Lime	
3085'	3178'	Shale and lime	
3178'	3471'	Lime	
3471'	3490'	Arbuckle	Ran 114 jts. 5 1/2" OD casing. Set at 3490' with 115 sacks cement. T.D. 3490'

RECEIVED
STATE CORPORATION COMMISSION

OCT 3 1962

CONSERVATION DIVISION
Wichita, Kansas