


WELL PLUGGING RECORD

Give All Information Completely
Make Required Affidavit
Mail or Deliver Report to:
Conservation Division
State Corporation Commission
800 Biwing Building
Wichita, Kansas

Barton County. Sec. 4 Twp. 20 Rge. 13 (X) W (W)

Location as "NE/CNWxSWx" or footage from lines C S/2 SE SW
Lease Owner Petroleum, Inc.
Lease Name Richter Well No. 1
Office Address Route 2, Great Bend, Kansas
Character of Well (completed as Oil, Gas or Dry Hole) Oil
Date well completed June 30 19 55
Application for plugging filed November 15 19 56
Application for plugging approved November 16 19 56
Plugging commenced November 17 19 56
Plugging completed November 24 19 56
Reason for abandonment of well or producing formation Depletion of
producibile zones.
If a producing well is abandoned, date of last production October 3 19 56
Was permission obtained from the Conservation Division or its agents before plugging was commenced? Yes

NORTH

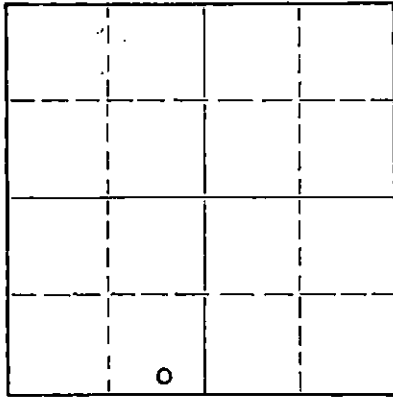

Locate well correctly on above
Section Plat

Name of Conservation Agent who supervised plugging of this well R.M. Brundege Hoisington, Kansas
Producing formation Kansas City Depth to top 3192' Bottom -- Total Depth of Well 3480 Feet
Show depth and thickness of all water, oil and gas formations.

OIL, GAS OR WATER RECORDS

CASING RECORD

FORMATION	CONTENT	FROM	TO	SIZE	PUT IN	PULLED OUT
Kansas City	Water and little oil	3255'	3260'	8 5/8" 4 1/2"	240' 3370'	None 2800'

Describe in detail the manner in which the well was plugged, indicating where the mud fluid was placed and the method or methods used in introducing it into the hole. If cement or other plugs were used, state the character of same and depth placed, from _____ feet to _____ feet for each plug set.

(Plugged back to 3305.5')

Filled hole with crushed rock from 3305.5' to 3245' and placed 5 sacks cement on top of rock. Globe oil Well Cementing Co. pumped 25 sacks Davis Jel (mud) on top of cement followed by a plug. Filled hole to base of well cellar with 100 sacks cement 3% CC.

(If additional description is necessary, use BACK of this sheet)

Name of Plugging Contractor Morgan Well Plugging Service
Address 102 West 18th Street, Hutchinson, Kansas

STATE OF KANSAS, COUNTY OF BARTON, ss.

DON SEARLE

(employee of owner) or (owner or operator) of the above-described well, being first duly sworn on oath, says: That I have knowledge of the facts, statements, and matters herein contained and the log of the above-described well as filed and that the same are true and correct. So help me God.

(Signature) Don Searle

Route 2, Great Bend, Kansas

(Address)

SUBSCRIBED AND SWORN TO before me this 29th day of November, 19 56

Jed B. Brown

Notary Public.

My commission expires July 11, 1960

PLUGGING
FILE SEC. 4 T. 20 R. 13W
BOOK PAGE 116 LINE 36

RECEIVED
STATE CORPORATION COMMISSION
DEC 1 - 1956
CONSERVATION DIVISION
Wichita, Kansas

12-1-56

WELL LOG

15.009.15909.0000

COMPANY **Petroleum, Inc.**

SEC. 4 T. 20S R. 13W

FARM **RICHTER**

NO. 1

LOC. **C S/2 SE SW**


TOTAL DEPTH **3480'**

COUNTY **Barton**

COMM. **June 14, 1955**

COMP. **June 24, 1955**

CONTRACTOR **Garvey Drilling Company**

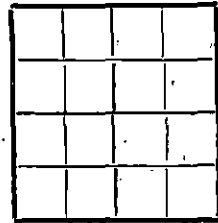

CASING **8-5/8" @ 240' w/175 sax**
4-1/2" @ 3370' w/75 sax

ELEVATION **1857 RB**

PRODUCTION **Lansing**

FIGURES INDICATE BOTTOM OF FORMATIONS

130	Surface Soil & Sand
420	Sand & Shale
760	Red Bed
770	Anhydrite
1425	Shale & Shells
2920	Lime & Shale
2995	Lime
3038	Lime & Shale
3075	Lime
3155	Shale
3350	Lime
3386	Lime & Shale
3462	Lime
3480	Lime & Shale

Geological Tops

Heebner:	3066 (-1209)
Brown Lime:	3181 (-1324)
Lansing:	3192 (-1335)
Conglomerate:	3427 (-1570)
Arbuckle:	3450 (-1593)

R. T.D. **3480'**

State of KANSAS
County of SEDGWICK

ss:

PLUGGING
FILE SEC 4 T 20 R 13W
BOOK PAGE 116 LINE 36

I, Karl E. Becker of Petroleum, Inc.

upon oath state that the above and foregoing is a true and correct copy of the log of the RICHTER #1 well

NOTARY COMMISSION

1955

Karl E. Becker

Subscribed and sworn to before me this 1st day of JULY 19 55

Notary, Kansas

My Commission Expires: 8-11-58

Patricia M. Edwards
NOTARY PUBLIC

PATRICIA M. EDWARDS, Notary Public
My Commission Expires August 11, 1958

15.009.15909.0000

PETROLEUM, INC.

ROUTE 2

GREAT BEND, KANSAS

NOVEMBER 15, 1956

MR. BILL MORGAN
MORGAN WELL PLUGGING SERVICE
102 WEST 18TH STREET
HUTCHINSON, KANSAS

DEAR MR. MORGAN:

THE FOLLOWING IS INFORMATION YOU WILL NEED IN THE PIPE PULLING AND PLUGGING OF ONE OF OUR ABANDONED WELLS:

WELL:	RICHTER #1
DESCRIPTION:	C-S/2-SE-SW, SEC. 4-20-13 BARTON COUNTY, KANSAS
ROTARY TOTAL DEPTH:	3,480'
PRESENT TOTAL DEPTH:	3,305½'
SURFACE CASING:	8-5/8" OD 28# SET AT 240', CEMENTED WITH 175 SACKS CEMENT, 2% GEL, 200# CC. CEMENT CIRCULATED.
PRODUCTION STRING:	4½" OD 11.60# J-55 RGE. 2 8#D THD. CASING. SET AT 3,370' CEMENTED WITH 75 SACKS CEMENT, 4% GEL.
TEMPERATURE SURVEY:	TOP OF CEMENT AT 2,950'
TOP CASING PERFORATIONS:	3,255'

PLEASE NOTIFY US AS TO WHEN YOU WILL MOVE ONTO THIS LOCATION.

YOURS TRULY,

PETROLEUM, INC.

Don Searle
DON SEARLE
ASSISTANT PRODUCTION SUPT.

DS:JF

CC: R. H. BRUNDEGE, 563 WEST 10TH, HOISINGTON, KANSAS
B. S. STRICKLETT, LYONS, KANSAS
JACK PERKINS, GREAT BEND, KANSAS
HARRY ADAMS, GREAT BEND, KANSAS
C. J. WILTSE, GREAT BEND, KANSAS

REC
STATE CORP.

NO

PLUGGING	
FILE NO.	T. R.
BOOK	PAGE
LINE	

CONSERVATION DIVISION

Wichita, Kansas