


WELL PLUGGING RECORD

Give All Information Completely
Make Required Affidavit
Mail or Deliver Report to:
Conservation Division
State Corporation Commission
800 Bittling Building
Wichita, Kansas

Barton County, Sec. 4 Twp. 20 Rge. 13 (E) (W)

Location as "NE/CNWxSWx" or footage from lines SW SW SE
Lease Owner Schermerhorn Oil Corporation
Lease Name Gaunt Well No. 1
Office Address P. O. Box 287, Tulsa 1, Oklahoma
Character of Well (completed as Oil, Gas or Dry Hole) Dry
Date well completed 6-3 1955
Application for plugging filed 6-2 1955
Application for plugging approved 6-2- 1955
Plugging commenced 6-3- 1955
Plugging completed 6-8- 1955
Reason for abandonment of well or producing formation Dry

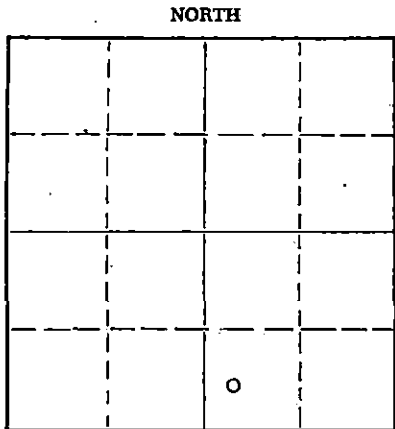

Locate well correctly on above Section Plat

If a producing well is abandoned, date of last production 19
Was permission obtained from the Conservation Division or its agents before plugging was commenced? Yes

Name of Conservation Agent who supervised plugging of this well Red Harner
Producing formation Depth to top Bottom Total Depth of Well 3520 Feet
Show depth and thickness of all water, oil and gas formations.

OIL, GAS OR WATER RECORDS

CASING RECORD

FORMATION	CONTENT	FROM	TO	SIZE	PUT IN	PULLED OUT
		0	723	8 5/8	Cemented	

Describe in detail the manner in which the well was plugged, indicating where the mud fluid was placed and the method or methods used in introducing it into the hole. If cement or other plugs were used, state the character of same and depth placed, from feet to feet for each plug set.

3520 to 723 Mud
723 to 650 Cement Plug
650 to 250 Mud
250 to Bottom Cellar - Cement

(If additional description is necessary, use BACK of this sheet)

Name of Plugging Contractor Badger Drillers, Inc.
Address Great Bend, Kansas

STATE OF Oklahoma COUNTY OF Tulsa, ss.
Frank M. Hammer (employee of owner) or (owner or operator) of the above-described well, being first duly sworn on oath, says: That I have knowledge of the facts, statements, and matters herein contained and the log of the above-described well as filed and that the same are true and correct. So help me God.

(Signature) *F. M. Hammer*
P. O. Box 287, Tulsa, Oklahoma
(Address)

SUBSCRIBED AND SWORN to before me this 13th day of June, 19 55

Julia Hargrave
Notary Public.

My commission expires 4-13-58

PLUGGING
FILE SEC 4 T 20 R 13W
BOOK PAGE 25 LINE 33

RECEIVED
STATE CORPORATION COMMISSION
JUN 15 1955 6-15-55
CONSERVATION DIVISION
Wichita, Kansas