


STATE OF KANSAS
STATE CORPORATION COMMISSION

WELL PLUGGING RECORD

Give All Information Completely
Make Required Affidavit
Mail or Deliver Report to
Conservation Division
State Corporation Comm.
245 North Water
Wichita, KS 67202

Barton County, Sec. 6 Twp. 20S Rge. 13W 1E/W
Location as "NE/CNW $\frac{1}{4}$ SW $\frac{1}{4}$ " or footage from lines
SE/4 NW/4 NW/4

Lease Owner Gear Petroleum Company, Inc.
Lease Name Brining Well No. 1
Office Address 300 Sutton Place, Wichita, Kansas 67202
Character of Well (Completed as Oil, Gas or Dry Hole)
D & A

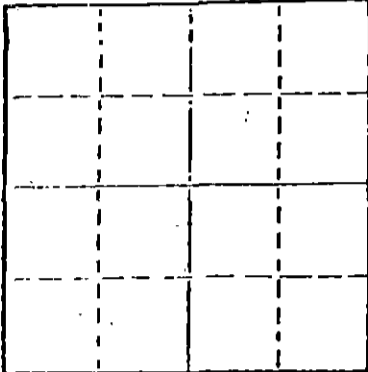

Locate well correctly on above
Section Plot

Date Well completed May 2, 1981
Application for plugging filed May 2, 1981
Application for plugging approved May 2, 1981
Plugging commenced May 2, 1981
Plugging completed May 2, 1981
Reason for abandonment of well or producing formation
D & A

If a producing well is abandoned, date of last production
19

Was permission obtained from the Conservation Division or
its agents before plugging was commenced? Yes

Name of Conservation Agent who supervised plugging of this well Duane L. Rankin
Producing formation _____ Depth to top _____ Bottom _____ Total Depth of Well 3,540'
Show depth and thickness of all water, oil and gas formations.

OIL, GAS OR WATER RECORDS

CASING RECORD

FORMATION	CONTENT	FROM	TO	SIZE	PUT IN	PULLED OUT
				8 5/8"	771.70'	-0-

Describe in detail the manner in which the well was plugged, indicating where the mud fluid
was placed and the method or methods used in introducing it into the hold. If cement or other
plugs were used, state the character of same and depth placed, from _____ feet to
_____ feet for each plug set.

Hole plugged @ 775' w/40 sx cement
@ 250' w/20 sx cement
1/2 sx Hulls & Plug @ 40' w/10 sx cement to surface
5 sx cement in rathole
50-50 Pozmix, 4% Gel, 3% C.C.

(If additional description is necessary, use BACK of this sheet)

Name of Plugging Contractor Red Tiger Drilling Company & Allied Cementing Company
1720 KSB Building, Wichita, Kansas 67202

STATE OF Kansas COUNTY OF Sedgwick, ss. contractor
Gloria Fawcett (employee of ~~operator~~)

of the above-described well, being first duly sworn on oath, says: That I have knowledge of
the facts, statements, and matters herein contained and the log of the above-described well
as filed and that the same are true and correct. So help me God.

(Signature) Gloria Fawcett
1720 KSB Building, Wichita, Kansas 67202
(Address)

SUBSCRIBED AND SWORN TO before me this 6th day of May, 1981.

My commission expires _____

Joyce A. Baer
Notary Public.

RECEIVED
STATE CORPORATION COMMISSION
5-14-81
MAY 14 1981



CONSERVATION DIVISION
Wichita, Kansas

DRILLERS LOG

No. 1 Brining

CASING RECORD:	COMPANY:	Gear Petroleum Company, Inc.	DESCRIPTION:
8 5/8" @ 779'	CONTRACTOR:	Red Tiger Drilling Company	SE/4 NW/4 NW/4
w/375 sx cement	COMMENCED:	April 23, 1981	Sec. 6-T20S-R13W
D & A	COMPLETED:	May 2, 1981	Barton County, Kansas

<u>FORMATION</u>	<u>FROM</u>	<u>TO</u>	<u>REMARKS</u>
Clay & Sand	0	158	
Shale & Sand	158	380	
Shale & Red Bed	380	708	
Shale	708	770	
Anhydrite	770	790	
Shale	790	1535	
Shale & Lime	1535	1820	
Lime & Shale	1820	2711	
Lime	2711	3540	
RTD		3540	

I certify that this is a true and correct copy of the above log to the best of my knowledge.

RED TIGER DRILLING COMPANY

Gloria Fawcett
Gloria Fawcett

Subscribed and sworn to before me this 6th day of May, 1981.

Joyce A. Baer
Notary Public



RECEIVED
STATE CORPORATION COMMISSION

MAY 14 1981

CONSERVATION DIVISION
Wichita, Kansas