


Give All Information Completely
Make Required Fee
Mail or Deliver Report to:
Conservation Division
State Corporation Commission
800 Bitting Building
Wichita, Kansas

WELL PLUGGING RECORD

NORTH

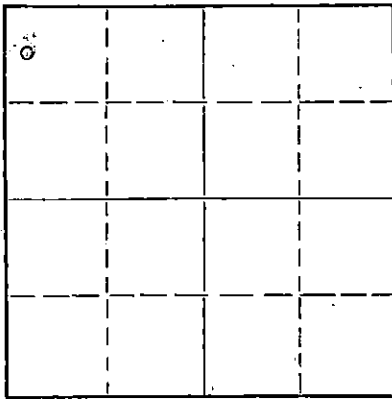

Locate well correctly on above
Section Plat

Barton County, Sec. 24 Twp. 20 Rge. 13 (E) W (W)
Location as "NE/CNW%SW%" or footage from lines W/2 NW NW
Lease Owner Harms - Burt Drilling Company
Lease Name Batchman Well No. _____
Office Address Box 184, Great Bend, Kansas
Character of Well (completed as Oil, Gas or Dry Hole) Dry Hole
Date well completed March 16, 19 55
Application for plugging filed March 16, 19 55
Application for plugging approved March 16, (orally) 19 55
Plugging commenced March 16, 19 55
Plugging completed March 16, 19 55
Reason for abandonment of well or producing formation Dry Hole

If a producing well is abandoned, date of last production 19 _____
Was permission obtained from the Conservation Division or its agents before plugging was commenced? Yes

Name of Conservation Agent who supervised plugging of this well Warren H. Herner, Box 207, Great Bend, Kans.
Producing formation _____ Depth to top _____ Bottom _____ Total Depth of Well 3520 Feet
Show depth and thickness of all water, oil and gas formations.

OIL, GAS OR WATER RECORDS

CASING RECORD

FORMATION	CONTENT	FROM	TO	SIZE	PUT IN	PULLED OUT
Surface		0	200'	8 5/8"	200'	None

Describe in detail the manner in which the well was plugged, indicating where the mud fluid was placed and the method or methods used in introducing it into the hole. If cement or other plugs were used, state the character of same and depth placed, from _____ feet to _____ feet for each plug set.

Filled hole with mud from 3520 TD to 200'.
Set plug at 200' with 20 sacks of cement on top.
Heavy mud to 30' with plug set at 35'
10 sacks cement on top of plug.

(If additional description is necessary, use BACK of this sheet)
Name of Plugging Contractor Harms - Burt Drilling Company.
Address Box 184, Great Bend, Kansas

STATE OF Kansas, COUNTY OF Barton, ss.
Allan Harms (employee of owner) or (owner or operator) of the above-described well, being first duly sworn on oath, says: That I have knowledge of the facts, statements, and matters herein contained and the log of the above-described well as filed and that the same are true and correct. So help me God.

(Signature) Allan Harms
Box 184, Great Bend, Kansas
(Address)

SUBSCRIBED AND SWORN TO before me this 13 day of May, 1955

My commission expires Jan 20, 1958
Mary E Van Belt
Notary Public.

RECEIVED
STATE CORPORATION COMMISSION
5-14-55

PLUGGING
FILE SEC 24 TWP 20 R 13W
BOOK PAGE 105 LINE 29

DRILLER'S LOG

Company: Harms-Burt Drilling Co.

Farm: Batchman #1 W/2 NW NW

Sec. 24-20S-13W, Barton County, Kansas

Commenced: March 8, 1955

Completed: March 16, 1955

Elevation: 1864' KB

0 - 30	Surface clay & sand	2575 - 2760	lime & shale
30 - 80	Sand	2760 - 3010	lime
80 - 100	shale	3010 - 3088	lime & shale
100 - 120	Pyrite & sand	3088 - 3092	Heebner shale
120 - 260	shale & shells	3092 - 3110	lime & shale
260 - 680	shale & red bed	3110 - 3207	shale & lime
680 - 705	Anhydrite	3207 - 3486	lime
705 - 950	Red bed & shale	3486 - 3509	conglomerate - chert
950 - 1160	shale & shells	3509 - 3520	Arbuckle
1160 - 1530	shale & shells with salt	3520 -	T.D.
1530 - 1570	shale & lime		
1570 - 1900	lime & shale		
1900 - 2575	shale & Lime		

Set 200' of 8 5/8" surface pipe. Cemented with 200 sacks of common cement & 4 sacks of calcium chloride.

Tops: Anhydrite 680
 Heebner 3088
 Brown Lime 3207
 Lansing - KC 3220
 Conglomerate 3457
 Arbuckle 3509

Drill Stem Tests: #1 Open 20 minutes. Recovered 10' of mud.
 BHP 1035#; Flow pressure 0-12#; in 15 minutes.

Dry, plugged & abandoned.

Affidavit: State of Kansas)
 County of Barton) SS

I, Allan Harms of Harms-Burt Drilling Company, being first duly sworn on oath state: That I have knowledge of the facts, statements, and matters herein contained and that the same are true and correct.

Signed Allan HarmsSubscribed and sworn to before me this 13 day of May, 1955

Comm. Exp. 1-20-58

Mary E Van Pelt
 Notary Public.

RECEIVED
 STATE CORPORATION COMMISSION

CONSERVATION

PLUGGING

MAN DIVISION
 FILE NO. 24-20-13W
 PAGE 109 LINE 29