


WELL PLUGGING RECORD

Give All Information Completely  
Make Required Affidavit  
Mail or Deliver Report to:  
Conservation Division  
State Corporation Commission  
212 North Market, Insurance Bldg.  
Wichita, Kansas

Barton County. Sec. 24 Twp. 20S Rge. 13W (E) (W)  
Location as "NE/CNW/SW" or footage from lines SE SW SE  
Lease Owner ALPINE OIL & ROYALTY CO., INC.  
Lease Name Schermuly Well No. 1  
Office Address 800 Bitting Building, Wichita, Kansas  
Character of Well (completed as Oil, Gas or Dry Hole) dry hole  
Date well completed December 20, 1959 19  
Application for plugging filed December 20, 1959 19  
Application for plugging approved December 20, 1959 19  
Plugging commenced December 20, 1959 19  
Plugging completed December 20, 1959 19  
Reason for abandonment of well or producing formation non-productive in commercial quantities  
If a producing well is abandoned, date of last production \_\_\_\_\_ 19  
Was permission obtained from the Conservation Division or its agents before plugging was commenced? Yes

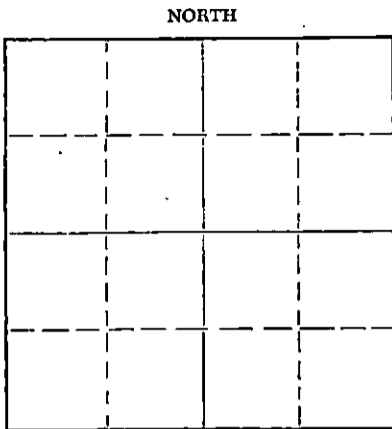

Locate well correctly on above Section Plat

Name of Conservation Agent who supervised plugging of this well Donald Truand  
Producing formation \_\_\_\_\_ Depth to top \_\_\_\_\_ Bottom \_\_\_\_\_ Total Depth of Well 3570 Feet  
Show depth and thickness of all water, oil and gas formations.

OIL, GAS OR WATER RECORDS				CASING RECORD		
FORMATION	CONTENT	FROM	TO	SIZE	PUT IN	PULLED OUT
				8 5/8"	182'	cemented

Describe in detail the manner in which the well was plugged, indicating where the mud fluid was placed and the method or methods used in introducing it into the hole. If cement or other plugs were used, state the character of same and depth placed, from \_\_\_\_\_ feet to \_\_\_\_\_ feet for each plug set.

Mud from Total Depth 3570 feet to 182 feet - 1/4th sack hulls and plug - 25 sacks cement - mud to 40 feet - 1/2 sack hulls and plug with 10 sacks cement to cellar

STAT. RECEIVED  
JAN 4 1960  
CONSERVATION DIVISION  
Wichita, Kansas

(If additional description is necessary, use BACK of this sheet)  
Name of Plugging Contractor Quaker Drilling Co., Inc.  
Address 800 Bitting Building, Wichita, Kansas

STATE OF Kansas, COUNTY OF Sedgwick, ss.  
Dwight J. Wilson (employee of owner) or (owner or operator) of the above-described well, being first duly sworn on oath, says: That I have knowledge of the facts, statements, and matters herein contained and the log of the above-described well as filed and that the same are true and correct. So help me God.

(Signature) Dwight J. Wilson  
800 Bitting Building, Wichita, Kansas  
(Address)

SUBSCRIBED AND SWORN TO before me this 31st day of December, 1959

My commission expires August 10, 1961

Ernest Mundell  
Notary Public.



  
 WELL LOG

ALPINE OIL &amp; ROYALTY CO., INC.

Commenced: 12-11-59

Contractor: Quaker Drilling Co., Inc.

Completed: 12-20-59

No. 1 Schermaly  
 SE SW SE Sec. 24-20S-13W  
 Barton County, Kansas

Elevation: 1856 KB

Production: D. &amp; A.

## Casing Record

Set 8 5/8" casing at 182 feet with 200 sacks cement

(Figures Indicate the Bottom of the Formations)

<u>FORMATION</u>	<u>DEPTH</u>	<u>FORMATION TOPS</u>
Surface Soil	20	Heebner 3083 -1227
Sand and Gravel	100	Brown Lime 3208 -1352
Very Hard Sand	115	Lansing 3221 -1365
Sand	118	Base of Kansas City 3443 -1587
Hard Sand	122	Conglomerate 3461 -1605
Blue Shale	150	Arbuckle 3484 -1628
Hard Sand	155	Rotary Total Depth 3570 -1714
Shale and Shells	182	
Shale and Red Bed	683	
Anhydrite	710	
Shale and Shells	1530	
Lime and Shale	1610	
Sandy Lime and Shale	1725	
Lime and Shale	2045	
Shale and Shells	2625	
Shale and Lime	3180	
Lime	3242	
Lime and Chert	3300	
Lime	3440	
Lime and Shale	3450	
Chert and Shale	3484	
Dolomite and Chert	3570	

**RECEIVED**  
 STATE CORPORATION COMMISSION

JAN 4 1960

CONSERVATION DIVISION  
 Wichita, Kansas

We hereby certify the foregoing to be a true and correct copy of the Driller's Log of the test drilled in the SE SW SE of Section 24, Township 20 South, Range 13 West, Barton County, Kansas.

QUAKER DRILLING CO., INC.

By:

  
 Thomas M. McCaul, President

SUBSCRIBED AND SWORN TO before me a Notary Public this 28th day of December, 1959.

  
 Virginia Mandell, Notary Public

MY COMMISSION EXPIRES:  
 August 10, 1961