


WELL PLUGGING RECORD

Give All Information Completely
Make Required Affidavit
Mail or Deliver Report to:
Conservation Division
State Corporation Commission
211 W. Broadway
Wichita, Kansas

BARTON County, Sec. 35 Twp. 20 Rge. 13 (N) W (W)

Location as "NE/CNW/SW" or footage from lines NE NW SE
Lease Owner TENNECO OIL COMPANY
Lease Name Albert Dohrmann Well No. 1
Office Address 1600 Main
Character of Well (completed as Oil, Gas or Dry Hole) Dry Hole
Date well completed February 28 1962
Application for plugging filed February 28 1962
Application for plugging approved 19
Plugging commenced February 28 1962
Plugging completed February 28 1962
Reason for abandonment of well or producing formation Dry Hole

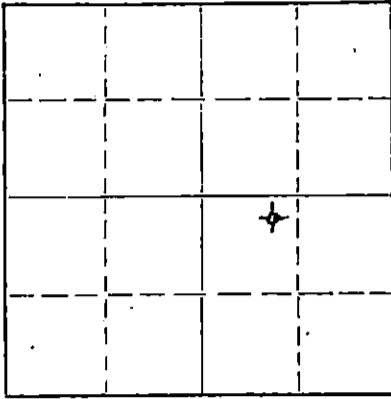

Locate well correctly on above Section Plat

If a producing well is abandoned, date of last production 19
Was permission obtained from the Conservation Division or its agents before plugging was commenced? Yes

Name of Conservation Agent who supervised plugging of this well Mr. Don Truan
Producing formation _____ Depth to top _____ Bottom _____ Total Depth of Well 3590 Feet
Show depth and thickness of all water, oil and gas formations.

OIL, GAS OR WATER RECORDS

CASING RECORD

FORMATION	CONTENT	FROM	TO	SIZE	PUT IN	PULLED OUT

Describe in detail the manner in which the well was plugged, indicating where the mud fluid was placed and the method or methods used in introducing it into the hole. If cement or other plugs were used, state the character of same and depth placed, from _____ feet to _____ feet for each plug set.

Filled hole with heavy mud.
Set plug 1/3 sack Hulls and 20 sacks Cement @ 400'
Filled hole with heavy mud to 250'
Set plug 1/3 sack Hulls and 20 sacks Cement @ 250'
Filled hole with heavy mud to 35'
Set plug 1/3 sack Hulls and 10 sacks Cement @ 35'
Plugged rat hole.

RECEIVED
STATE CORPORATION COMMISSION

MAR 6 1962

CONSERVATION DIVISION
Wichita

(If additional description is necessary, use BACK of this sheet)

Name of Plugging Contractor Duke Drilling Co.
Address P.O. Box 823, Great Bend, Ks.

STATE OF KANSAS COUNTY OF BARTON ss.

Lewis O. Chubb (contractor) of the above-described well, being first duly sworn on oath, says: That I have knowledge of the facts, statements, and matters herein contained and the log of the above-described well as filed and that the same are true and correct. So help me God.

(Signature)

P.O. Box 823, Great Bend, Kansas
(Address)

SUBSCRIBED AND SWORN TO before me this 2nd day of March, 1962

My commission expires June 24, 1963

Clair E. Stinson
Notary Public.

DRILLER'S WELL LOG

DATE COMMENCED: February 19, 1962
 DATE COMPLETED: February 28, 1962

TENNECO OIL COMPANY
 "Albert Dohrmann # 1"
 NE NW SE Sec. 35-20s-13w
 Barton County, Kansas

0 - 214'	Sand and clay
214 - 257'	Red Bed
257 - 700'	Red Bed
700 - 730'	ANHYDRITE
730 - 1530'	Shale salt shells
1530 - 2140'	Lime and shale
2140 - 2630'	Shale and Lime
2630 - 2950'	Lime and shale
2950 - 3117'	Lime
3117 - 3241'	Shale-lime HEEBNER
3241 - 3257'	Lime & Shale BROWN LIME
3257 - 3505'	Lime LANSING
3505 - 3544	Conglomerate cherty
3544 - 3590	Dolomite ARBUCKLE
3590	R.T.D.

ELEVATION: 1869 K.B.
 1865 G.L.


FORMATION DATA:
 ANHYDRITE 700-730
 HEEBNER 3117
 BROWN LIME 3241
 LANSING 3256
 ARBUCKLE 3544
 R.T.D. 3590

SURFACE CASING: Set 8-5/8"
 new casing @ 257' with 175 sacks
 cement by Sun Cementing Co.

A F F I D A V I T

STATE OF KANSAS)
 COUNTY OF BARTON) ss.

Lewis O. Chubb of lawful age, does swear that the facts and statements herein contained are true and correct to the best of his knowledge.

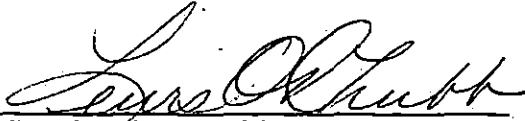
 Lewis O. Chubb

Subscribed and sworn to before me this 2nd day of March, 1962.


 Clair E. Stimson-NOTARY PUBLIC

My Commission Expires: June 24, 1963.

RECEIVED
 STATE CORPORATION COMMISSION

MAR 6 1962

CONSERVATION DIVISION
 Wichita, Kansas