

OR

STATE OF KANSAS  
STATE CORPORATION COMMISSION


WELL PLUGGING RECORD

Give All Information Completely  
Make Required Affidavit  
Mail or Deliver Report to:  
Conservation Division  
State Corporation Commission  
211 No. Broadway  
Wichita, Kansas

Barton County, Sec. 35 Twp. 20 Rge. (E) 13 (W)

Location as "NE/CNW/SW" or footage from lines SW NW SE  
Lease Owner Circle Oil Company, Inc.  
Lease Name Dohrmann Well No. 1  
Office Address 816 Bitting Building, Wichita, Kansas  
Character of Well (completed as Oil, Gas or Dry Hole) Dry Hole  
Date well completed 5/27/65 19  
Application for plugging filed 19  
Application for plugging approved 19  
Plugging commenced 5/27/65 19  
Plugging completed 5/27/65 19  
Reason for abandonment of well or producing formation Dry Hole

NORTH

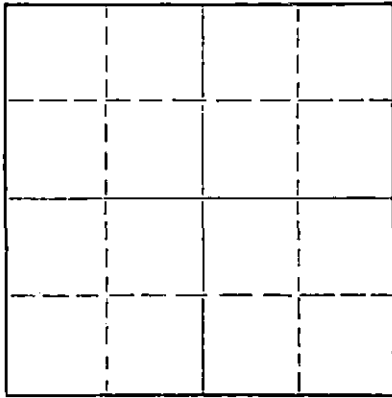

Locate well correctly on above  
Section Plat

If a producing well is abandoned, date of last production 19  
Was permission obtained from the Conservation Division or its agents before plugging was commenced? Yes (Donald Truan)

Name of Conservation Agent who supervised plugging of this well  
Producing formation Depth to top Bottom Total Depth of Well 3580 Feet  
Show depth and thickness of all water, oil and gas formations.

OIL, GAS OR WATER RECORDS

CASING RECORD

FORMATION	CONTENT	FROM	TO	SIZE	PUT IN	PULLED OUT
	Surface	0	245	8-5/8"	5/22/65	
	Casing					

Describe in detail the manner in which the well was plugged, indicating where the mud fluid was placed and the method or methods used in introducing it into the hole. If cement or other plugs were used, state the character of same and depth placed, from feet to feet for each plug set.

Heavy Mud from Total Depth to 240 feet;  
Hull Plug, HOWCO plug and 25 sacks cement  
through drill pipe; Heavy Mud to 40 feet,  
1/2 sack Hulls and plug and 10 sacks cement  
to bottom of cellar; 2 sacks in rat hole.

6-4-1965

RECEIVED  
STATE CORPORATION COMMISSION

JUN 4 1965

CONSERVATION DIVISION  
Wichita, Kansas

(If additional description is necessary, use BACK of this sheet)

Name of Plugging Contractor Sage Drilling Co., Inc.  
Address 816 Bitting Building, Wichita, Kansas

STATE OF KANSAS COUNTY OF SEDGWICK, ss.  
Thomas M. McCaul, Jr.

(employee or owner) or (owner or operator) of the above-described well, being first duly sworn on oath, says: That I have knowledge of the facts, statements, and matters herein contained and the log of the above-described well as filed and that the same are true and correct. So help me God.

(Signature) *Thomas M. McCaul, Jr.*  
816 Bitting Bldg., Wichita, Kansas

SUBSCRIBED AND SWORN TO before me this 3rd day of June 1965

My commission expires November 26, 1966. *Louise K. Whitted* Notary Public.

R

DRILLERS LOG

DOHRMANN NO. 1

CASING RECORD: 8-5/8" @ 245' w/125 sacks cement.

COMPANY: Circle Oil Co., Inc.

CONTRACTOR: Sage Drilling Co.

COMMENCED: May 22, 1965

TOTAL DEPTH: 3580'

COMPLETED: May 27, 1965

DESCRIPTION: SW NW SE Sec. 35-20S-13W Barton Co., Kansas

ELEVATION: 1876 KB

<u>FORMATION</u>	<u>FROM</u>	<u>TO</u>	<u>REMARKS</u>
Sand	0	210	
Shale	210	698	
Anhydrite	698	720	
Shale & Sandy Lime	720	1570	
Lime & Shale	1570	2450	
Shale & Lime	2450	2987	
Lime & Shale	2987	3247	
Lime	3247	3580	

RECEIVED  
STATE CORPORATION COMMISSION  
JUN 4 1965  
CONSERVATION DIVISION  
Wichita, Kansas

I certify that this is a true and correct copy of the above log to the best of my knowledge.

SAGE DRILLING COMPANY, INC.

*Thomas M. McCaul, Jr.*

Thomas M. McCaul, Jr.

Subscribed and sworn to before me this 3rd day of June, 1965.

*Louise K. Whitted*  
Louise K. Whitted, Notary Public

My Commission expires:  
November 26, 1966.