

STATE OF KANSAS
STATE CORPORATION COMMISSION


Give All Information Completely
Make Required Affidavit
Mail or Deliver Report to:
Conservation Division
State Corporation Commission
211 No. Broadway
Wichita, Kansas

WELL PLUGGING RECORD

Barton County, Sec. 35 Twp. 20S Rge. 13W (E) (W)

Location as "NE/CNW/SW" or footage from lines NE SW NE
Lease Owner ALPINE OIL & ROYALTY CO., INC.
Lease Name Dohrmann Well No. 3
Office Address 800 Bitting Building, Wichita, Ks.
Character of Well (completed as Oil, Gas or Dry Hole) dry hole
Date well completed 5-15-62 19__
Application for plugging filed 5-15-62 19__
Application for plugging approved 5-15-62 19__
Plugging commenced 5-15-62 19__
Plugging completed 5-15-62 19__
Reason for abandonment of well or producing formation non-productive

NORTH

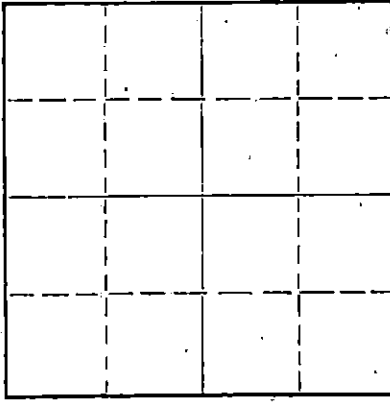

Locate well correctly on above
Section Plat

If a producing well is abandoned, date of last production _____ 19__
Was permission obtained from the Conservation Division or its agents before plugging was commenced? yes

Name of Conservation Agent who supervised plugging of this well Donald Truan
Producing formation _____ Depth to top _____ Bottom _____ Total Depth of Well 3570 Feet
Show depth and thickness of all water, oil and gas formations.

OIL, GAS OR WATER RECORDS

CASING RECORD

FORMATION	CONTENT	FROM	TO	SIZE	PUT IN	PULLED OUT
				8 5/8"	260	Cemented

Describe in detail the manner in which the well was plugged, indicating where the mud fluid was placed and the method or methods used in introducing it into the hole. If cement or other plugs were used, state the character of same and depth placed, from _____ feet to _____ feet for each plug set.

Heavy mud from 3570 feet to 220 feet. A plug and 1/4th sack hulls - 25 sacks cement through drill pipe mud to 35 x another plug and 1/4th hulls and 10 sacks cement - 2 sacks cement in rat hole - completed at 10:15 P.M.

RECEIVED
STATE CORPORATION COMMISSION

JUL 12 1963

CONSERVATION DIVISION
Wichita, Kansas

(If additional description is necessary, use BACK of this sheet)
Name of Plugging Contractor QUAKER DRILLING CO., INC.
Address 800 Bitting Building, Wichita, Ks.

STATE OF Kansas, COUNTY OF Sedgwick, ss.
Thomas M. McCaul (employee of owner) or (owner or operator) of the above-described well, being first duly sworn on oath, says: That I have knowledge of the facts, statements, and matters herein contained and the log of the above-described well as filed and that the same are true and correct. So help me God.

(Signature) Thomas M. McCaul
800 Bitting Building, Wichita, Ks.
(Address)

SUBSCRIBED AND SWORN to before me this 11st day of July 19 63

My commission expires August 10, 1965

[Signature]
Notary Public.

WELL LOG

ALPINE OIL & ROYALTY CO., INC.

Commenced: May 7, 1962

Contractor: Quaker Drilling Co., Inc.

Completed: May 15, 1962

Dohrmann No. 3
NE SW NE Sec. 35-20S-13W
Barton County, Kansas

Elevation: 1870 KB

Production: D & A

Set 8 5/8 inch casing at 260 feet with 250 sacks cement

(Figures Indicate the Bottom of the Formations)

FORMATION	DEPTH	FORMATION TOPS	
Sand	215	Heebner	3119 -1249
Shale	260	Brown Lime	3241 -1371
Red Bed	695	Lansing	3256 -1386
Anhydrite	720	Base of Kansas City	3481 -1611
Shale and Shells	1280	Conglomerate	3498 -1628
Shale and Lime	1730	Arbuckle	3565 -1695
Sandy Lime and Shale	1875	Rotary Total Depth	3570 -1700
Lime and Shale	2220		
Shale and Shells	2630		
Lime and Shale	3210		
Lime	3425		
Lime and Shale	3490		
Lime	3555		
Lime and Shale	3570		

RECEIVED
STATE CORPORATION COMMISSION

JUL 12 1963

CONSERVATION DIVISION
Wichita, Kansas

We hereby certify the foregoing to be a true and correct copy of the Driller's Log of the well drilled in the NE SW NE of Section 35-20S-13W, Barton County, Kansas.

QUAKER DRILLING CO., INC.

By: *Thomas M. Paul*

SUBSCRIBED AND SWORN TO before me a Notary Public this 11th day of July, 1963

Virginia Mundell
Virginia Mundell, Notary Public

MY COMMISSION EXPIRES:
August 10, 1965