


STATE OF KANSAS
STATE CORPORATION COMMISSION

WELL PLUGGING RECORD

Give All Information Completely
Make Required Affidavit
Mail or Deliver Report to
Conservation Division
State Corporation Comm.
245 North Water
Wichita, KS 67202

Rice County. Sec. 22 Twp. 20 Rge. 9 E/W
Location as "NE/CNW $\frac{1}{4}$ SW $\frac{1}{4}$ " or footage from lines
W/2 NE SE

Lease Owner P.V. Properties, Inc.
Lease Name BIRCHENOUGH Well No. #1
Office Address 360 Sutton Place Wichita, Kansas 67202
Character of Well (Completed as Oil, Gas or Dry Mole)

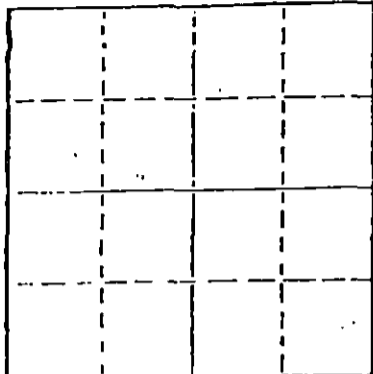

Locate well correctly on above
Section Plot

Date Well completed 5-6-1981
Application for plugging filed 5-6-1981
Application for plugging approved 5-6-1981
Plugging commenced 5-6-1981
Plugging completed 5-6-1981
Reason for abandonment of well or producing formation

If a producing well is abandoned, date of last production 19

Was permission obtained from the Conservation Division or its agents before plugging was commenced? yes

Name of Conservation Agent who supervised plugging of this well Marion Schmidt
Producing formation Depth to top Bottom Total Depth of Well 3388'
Show depth and thickness of all water, oil and gas formations.

OIL, GAS OR WATER RECORDS

CASING RECORD

FORMATION	CONTENT	FROM	TO	SIZE	PUT IN	PULLED OUT

Describe in detail the manner in which the well was plugged, indicating where the mud fluid was placed and the method or methods used in introducing it into the hold. If cement or other plugs were used, state the character of same and depth placed, from feet to feet for each plug set.

Bottom Plug: @ 480' w/50 sacks cement thru drill pipe
Middle Plug: @ 240' w/30 sacks " " " "
Top Plug: @ 40' w/10 sacks cement & solid bridge of $\frac{1}{2}$ sack hulls
5 sacks in rat hole

RECEIVED
STATE CORPORATION COMMISSION

MAY 12 1981

CONSERVATION DIVISION

(If additional description is necessary, use BACK of this form)
Name of Plugging Contractor Duke Drilling Co., Inc. 5-12-1981

STATE OF Kansas COUNTY OF Barton, ss.
Darrel Anderson (employee of owner) or (owner or operator)
of the above-described well, being first duly sworn on oath, says: That I have knowledge of the facts, statements, and matters herein contained and the log of the above-described well as filed and that the same are true and correct. So help me God.

(Signature) Darrel Anderson
P.O. Box 823 Great Bend, Kansas 67530
(Address)

SUBSCRIBED AND SWORN TO before me this 8 day of May, 19 81

Barbara M. Hogue
Notary Public.

My commission expires 4-11-1982

DRILLERS' WELL LOG

DATE COMMENCED: April 28, 1981
DATE COMPLETED: May 6, 1981

F.V. Properties, Inc.
BIRCHENOUGH #1
W/2 NE SE
Sec. 22, T20S, R9W
Rice County, Ks.

0 - 270' Surface Soil, Sand, Shale
270 - 287' Anhydrite
287 - 2884' Shale, Lime
2884 - 2918' Lime & Shale
2918 - 3212' Lime
3212 - 3382' Shale, Lime
3382 - 3388' Dolomite
3388' RTD

ELEVATION: 1685 K.B.

FORMATION DATA

Anhydrite 270'
Heehner 2751'
Brown Lime 2884'
Lansing K.C. 2918'
Base K.C. 3212'
Arbuckle 3382'
RTD 3388'

Surface Pipe: Set new 2 1/2",
8-5/8" pipe at 215' w/175
sacks 60/40 pozmix, 2% gal,
3% cc.

RECEIVED
STATE CORPORATION COMMISSION
MAY 12 1981
CONSERVATION DIVISION
Wichita, Kansas

AFFIDAVIT

STATE OF KANSAS
COUNTY OF HARTON) ss

Darrel Anderson of lawful age, does swear and state that the facts and
statements herein contained are true and correct to the best of his knowledge.

Darrel Anderson

Subscribed and sworn to before me this 8 day of May 1981.

My Comm. Expires:
4-11-1982

Wendy M. Hague
Notary Public