


STATE OF KANSAS
 STATE CORPORATION COMMISSION
 Give All Information Completely
 Make Required Affidavit
 Mail Or Deliver Report to:
 Conservation Division
 State Corporation Commission
 212 No. Market
 Wichita, Kansas

WELL PLUGGING RECORD

Rice County, Sec. 22 Twp. 20 Rge. 9 (E) W (W)
 Location as "NE/CNW/SW" or footage from lines NW SE SE
 Lease Owner Clinton Oil Company
 Lease Name Birchenough Well No. 5
 Office Address Wichita, Kansas, 6810 W. Highway 54
 Character of Well (completed as Oil, Gas or Dry Hole) Oil
 Date well completed _____ 19____
 Application for plugging filed 4-14 19 66
 Application for plugging approved 4-15 19 66
 Plugging commenced 4-20-66 19____
 Plugging completed 4-22-66 19____
 Reason for abandonment of well or producing formation Depleted

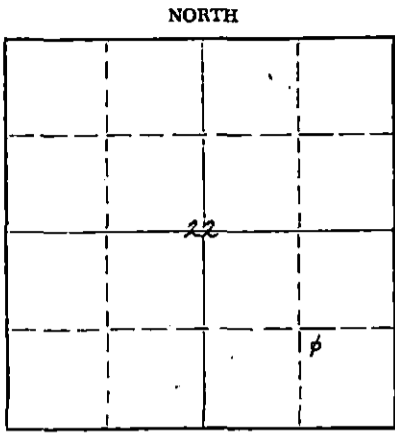

Locate well correctly on above Section Plat

If a producing well is abandoned, date of last production 4-1 1966
 Was permission obtained from the Conservation Division or its agents before plugging was commenced? yes

Name of Conservation Agent who supervised plugging of this well Gilbert Toman
 Producing formation _____ Depth to top _____ Bottom _____ Total Depth of Well 3382 Feet
 Show depth and thickness of all water, oil and gas formations.

OIL, GAS OR WATER RECORDS

CASING RECORD

FORMATION	CONTENT	FROM	TO	SIZE	PUT IN	PULLED OUT
				8-5/8"	194'	None
				5-1/2"	3380'	2624'

Describe in detail the manner in which the well was plugged, indicating where the mud fluid was placed and the method or methods used in introducing it into the hole. If cement or other plugs were used, state the character of same and depth placed, from _____ feet to _____ feet for each plug set.

Checked hole to 3382', sanded hole to 3370' and dumped 5 sacks of cement @ 3370' with dump bailer. Pulled 5 1/2" casing, bailed hole to 180', set rock bridge to 170' and dumped 20 sacks of cement. Mudded hole to 30', set rock bridge and ran 10 sacks of cement to base of cellar.

RECEIVED
 STATE CORPORATION COMMISSION
 APR 26 1966
 CONSERVATION DIVISION
 Wichita, Kansas

PLUGGING COMPLETE.

(If additional description is necessary, use BACK of this sheet)
 Name of Plugging Contractor KNIGHT CASING PULLING COMPANY
 Address CHASE, KANSAS

STATE OF KANSAS COUNTY OF RICE, ss.
Noel J. Knight (employee of owner) or (~~owner~~) of the above-described

well, being first duly sworn on oath, says: That I have knowledge of the facts, statements, and matters herein contained and the log of the above-described well as filed and that the same are true and correct. So help me God.

(Signature) Noel J. Knight
Chase, Kansas
 (Address)

SUBSCRIBED AND SWORN TO before me this 23rd day of April, 1966

My commission expires May 20, 1968
Milton J. Volin
 Notary Public.

