


Give All Information Completely
Make Required Affidavit
Mail or Deliver Report to:
Conservation Division
State Corporation Commission
212 No. Market
Wichita, Kansas

WELL PLUGGING RECORD

NORTH

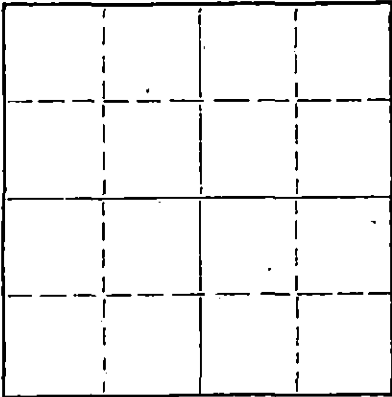

Locate well correctly on above
Section Plat

Rice County. Sec. 22 Twp 20 Rge. 9 (E) W (W)
Location as "NE/CNW/SW" or footage from lines NE NE SE
Lease Owner Clinton Oil Company
Lease Name Bircheonough Well No. 4
Office Address Wichita, Kansas
Character of Well (completed as Oil, Gas or Dry Hole) Oil
Date well completed September 16 19 62
Application for plugging filed November 8 19 66
Application for plugging approved November 14 19 66
Plugging commenced 11-22-66 19
Plugging completed 11-25-66 19
Reason for abandonment of well or producing formation Depleted.

If a producing well is abandoned, date of last production November 1 19 66
Was permission obtained from the Conservation Division or its agents before plugging was commenced? yes

Name of Conservation Agent who supervised plugging of this well Gilbert Toman
Producing formation _____ Depth to top _____ Bottom _____ Total Depth of Well 3378 Feet
Show depth and thickness of all water, oil and gas formations.

OIL, GAS OR WATER RECORDS

CASING RECORD

FORMATION	CONTENT	FROM	TO	SIZE	PUT IN	PULLED OUT
				10-3/4"	208'	None
				5-1/2"	3377'	2587'

Describe in detail the manner in which the well was plugged, indicating where the mud fluid was placed and the method or methods used in introducing it into the hole. If cement or other plugs were used, state the character of same and depth placed, from _____ feet to _____ feet for each plug set.

RM Checked hole to 3378', sanded hole to 3350' and
dumped 5 sacks of cement @ 3350' with dump bailer.
Pulled 5 1/2" casing, bailed hole to 205', set rock
bridge to 195' and dumped 25 sacks of cement.
Mudded hole to 25' and capped well with 10 sacks
of cement.

RECEIVED
STATE CORPORATION COMMISSION
12-8-1966

DEC 8 1966
CONSERVATION DIVISION
Wichita, Kansas

PLUGGING COMPLETE.

(If additional description is necessary, use BACK of this sheet)

Name of Plugging Contractor KNIGHT CASING PULLING COMPANY
Address CHASE, KANSAS

STATE OF KANSAS COUNTY OF RICE, ss.
Noel J. Knight (employee of owner) or (owner) of the above-described

well, being first duly sworn on oath, says: That I have knowledge of the facts, statements, and matters herein contained and the log of the above-described well as filed and that the same are true and correct. So help me God.

(Signature) Noel J. Knight
Chase, Kansas

SUBSCRIBED AND SWORN to before me this 30th day of November, 19 66

Milton J. Volin
Notary Public.

My commission expires May 20, 1968

RAYMOND OIL COMPANY, INC.
 No. 4 BIRCHENOUGH
 NE NE SE 22-20-9W
 Rice County, Kansas

ELEVATION: 1681 KB
 1679 DF

Contractor: Raymond Drilling Company - Rig #7
 Commenced: September 8, 1962
 Completed: September 16, 1962 (Rotary)

Casing Record:
 10-3/4" @206' w/200 Sx.
 5-1/2" @3377' w/150 Sx.

Figures Indicate Bottom of Formation

<u>Formation</u>	<u>Depth</u>
Clay and Sand	100
Redbed and Shale	268
Anhydrite	280
Shale and Shells	1110
Shale and Lime	2454
Lime	2726
Lime and Shale	3010
Lime	3310
Shale and Sand	3375
Arbuckle	3377 TD

RECEIVED
 NOV 14 1966
 CONSERVATION DIVISION
 WICHITA, KANSAS

TOPS

Heebner	2738
Brown Lime	2876
Lansing - Kansas City	2908
Base Kansas City	3201
Macquoketa	3241
Viola	3274
Simpson	3320
Arbuckle	3376
Rotary Total Depth	3377

STATE OF KANSAS)
) SS.
 COUNTY OF SEDGWICK)

I hereby certify that the above is true and correct to the best of my knowledge.

Wm. M. Raymond
 Wm. M. Raymond, President

Subscribed and sworn to before me this 25th day of September, 1962.

Barbara A. Kennedy
 Notary Public

My commission expires:
 July 9, 1966