

15.159.02633.0000



File


STATE OF KANSAS STATE CORPORATION COMMISSION

Give All Information Completely Make Required Affidavit Mail or Deliver Report to: Conservation Division State Corporation Commission 212 No. Market Wichita, Kansas 67202

WELL PLUGGING RECORD

Rice County, Sec. 22 Twp. 20 Rge. 9 (E) (W)

Location as "NE/CNWxSWx" or footage from lines NE SE SE Lease Owner Clinton Oil Company Lease Name Birchenough #2 Office Address Wichita, Kansas Character of Well (completed as Oil, Gas or Dry Hole) Date well completed Application for plugging filed Application for plugging approved Plugging commenced 7/1/70 Plugging completed 7/7/70 Reason for abandonment of well or producing formation depleted.

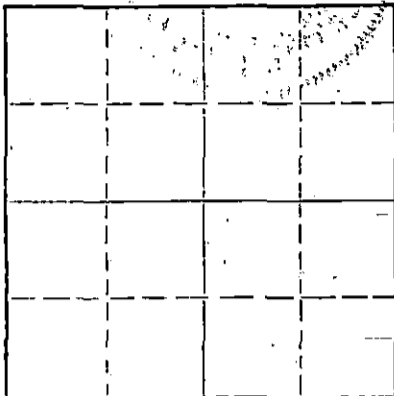

Locate well correctly on above Section Plat

If a producing well is abandoned, date of last production Was permission obtained from the Conservation Division or its agents before plugging was commenced? yes

Name of Conservation Agent who supervised plugging of this well Toman Producing formation Depth to top Bottom Total Depth of Well 3373 Feet Show depth and thickness of all water, oil and gas formations.

OIL, GAS OR WATER RECORDS


CASING RECORD

Table with 7 columns: FORMATION, CONTENT, FROM, TO, SIZE, PUT IN, PULLED OUT. Contains data for casing sizes 8-5/8 and 5 1/2 inches.

Describe in detail the manner in which the well was plugged, indicating where the mud fluid was placed and the method or methods used in introducing it into the hole. If cement or other plugs were used, state the character of same and depth placed, from feet to feet for each plug set.

Checked hole to 3373', ran sand to 3360' and dumped 5 sacks of cement. Shot pipe at 2715', 2618', spotted 35 barrels of oil behind pipe. Shot pipe at 2500', 2310', 2111', 1908', 1805', 1710', 1614', 1520', 1425', worked pipe loose and pulled 45 joints. Bailed fluid down to 200', set rock bridge and dumped 25 sacks of cement. Mudded to 40', set 10' rock bridge and dumped 10 sacks of cement.

PLUGGING COMPLETE.

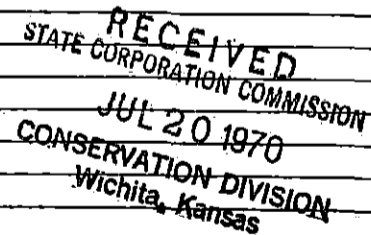


Name of Plugging Contractor KNIGHT CASING PULLING CO., INC. Address CHASE, KANSAS

STATE OF KANSAS COUNTY OF RICE, ss. NOEL J. KNIGHT

(employee of owner) or (owner or operator) of the above-described well, being first duly sworn on oath, says: That I have knowledge of the facts, statements, and matters herein contained and the log of the above-described well as filed and that the same are true and correct. So help me God.

(Signature) Noel Knight CHASE, KANSAS

Subscribed and sworn to before me this 13th day of July, 1970

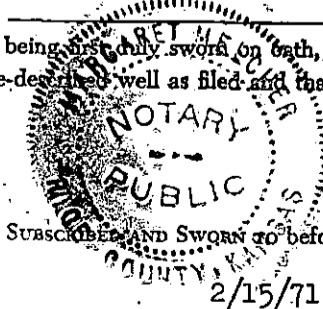

Margaret Melcher Notary Public.

My commission expires

