


STATE OF KANSAS
STATE CORPORATION COMMISSION

WELL PLUGGING RECORD

Give All Information Completely
Make Required Affidavit
Mail or Deliver Report to:
Conservation Division
State Corporation Commission
212 North Market Insurance Bldg.
Wichita, Kansas

Rice County, Sec. 33 Twp. 20 Rge. 9 ~~029~~ (W)
Location as "NE/CNW/SW" or footage from lines NE NE SW
Lease Owner Thomas H. Allan
Lease Name Clark Ward Well No.
Office Address Union Center Bldg. - Wichita, Kansas
Character of Well (completed as Oil, Gas or Dry Hole) Dry Hole
Date well completed 5 April 19 63
Application for plugging filed 5 April 19 63
Application for plugging approved 5 April 19 63
Plugging commenced 5 April 19 63
Plugging completed 5 April 19 63
Reason for abandonment of well or producing formation Dry Hole

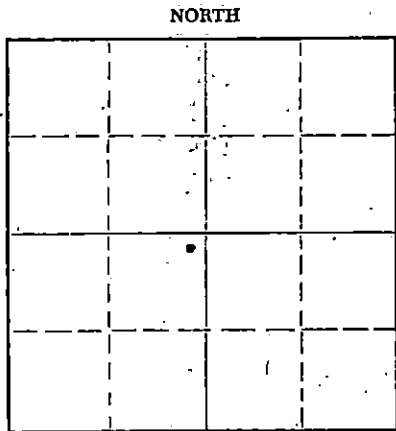

Locate well correctly on above
Section Plat

If a producing well is abandoned, date of last production 19
Was permission obtained from the Conservation Division or its agents before plugging was commenced?

Name of Conservation Agent who supervised plugging of this well Cecil Jones
Producing formation Depth to top Bottom Total Depth of Well 3,347 Feet
Show depth and thickness of all water, oil and gas formations.

OIL, GAS OR WATER RECORDS

CASING RECORD

FORMATION	CONTENT	FROM	TO	SIZE	PUT IN	PULLED OUT

Describe in detail the manner in which the well was plugged, indicating where the mud fluid was placed and the method or methods used in introducing it into the hole. If cement or other plugs were used, state the character of same and depth placed, from feet to feet for each plug set.

Filled Hole with heavy mud to 200 feet. Set plug and 1/4 sack hulls and 20 sacks of cement through drill pipe.
Filled hole with heavy mud to 40 feet. Set plug, 1/4 sack hulls and eight sacks of cement. Put 2 sacks cement in rat hole.

RECEIVED
STATE CORPORATION COMMISSION

APR 12 1963

CONSERVATION DIVISION
Wichita, Kansas

(If additional description is necessary, use BACK of this sheet)

Name of Plugging Contractor Burt Drilling Co.
Address Great Bend, Kansas

STATE OF Kansas, COUNTY OF Barton, ss.
Duke C. Burt (employee or owner) or (owner or operator) of the above-described well, being first duly sworn on oath, says: That I have knowledge of the facts, statements, and matters herein contained and the log of the above-described well as filed and that the same are true and correct. So help me God.

(Signature) Duke C. Burt
Great Bend, Kansas
(Address)

SUBSCRIBED AND SWORN to before me this 10 day of April, 19 63

My commission expires August 26, 1965
Zona George Notary Public.



THOMAS H. ALLAN
 Union Center Bldg.
 Wichita, Kansas

WELL: Clark Ward No. 1
 COMMENCED R.D.: 3/28/63
 COMPLETED R.D.: 4/5/63
 TOTAL DEPTH: 3,347' D.F.
 CASING: 207' of Used 8 5/8" - 200 sx

Sec. 33-20-9
 Rice County, Kansas
 Elevation:
 Initial Prod: D & A
 Contractor: BURT DRILLING
 COMPANY

Strata	Depth
Sand	0- 75'
Shale & redbed	75- 265
Anhydrite	265-290
Shale & shells	290-1140
Lime & shale	1140-1148
Lime w/shale streaks	1148-1765
Shale & lime	1765-2405
Shale, lime & sand	2405-2503
Shale & lime	2503-2545
Lime & shale	2545-2675
Lime	2675-2820
Lime & shale	2820-2830
Shale & sand	2830-2911
Lime (BR)	2911-2948
Lime (Lansing)	2948-2965
Lime	2965-3255
Shale & lime	3255-3287
Sand	3287-3295
Conglomerate (Cherty)	3295-3315
Lime (Arbuckle)	3315-3347

I hereby certify that the above is a true and correct log of said well as reflected by daily reports.

BURT DRILLING COMPANY

[Signature]

Signed and sworn to in my presence this 16 day of April, 1963.

[Signature]
 Notary Public

My Commission Expires: Aug. 26, 1965

RECEIVED
 STATE CORPORATION COMMISSION
 APR 12 1963
 CONSERVATION DIVISION
 Wichita, Kansas