


STATE OF KANSAS  
STATE CORPORATION COMMISSION

WELL PLUGGING RECORD

Give All Information Completely  
Make Required Affidavit  
Mail or Deliver Report to:  
Conservation Division  
State Corporation Commission  
P. O. Box 17027  
Wichita, Kansas 67217  
NORTH

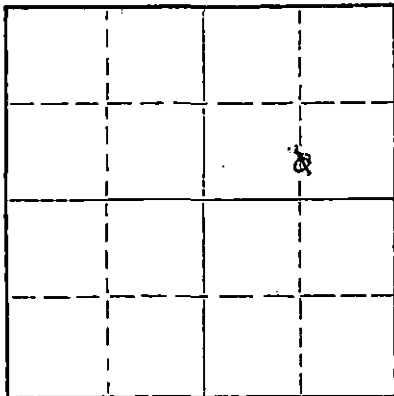

Locate well correctly on above  
Section Plat

Rice County, Sec. 32 Twp. 20 Rge. 9 (E) W (W)  
Location as "NE/CNW/SW" or footage from lines C S/2 NE Sec. 32-20-9W  
Lease Owner: Aladdin Petroleum Corporation  
Lease Name: Shepherd Well No. 1  
Office Address: 809 Petroleum Building, Wichita, Kansas 67202  
Character of Well (completed as Oil, Gas or Dry Hole) Dry hole  
Date well completed May 18 1972  
Application for plugging filed May 18 1972  
Application for plugging approved May 18 1972  
Plugging commenced May 18 1972  
Plugging completed May 18 1972  
Reason for abandonment of well or producing formation

If a producing well is abandoned, date of last production 19  
Was permission obtained from the Conservation Division or its agents before plugging was commenced? Yes

Name of Conservation Agent who supervised plugging of this well Gilbert Toman  
Producing formation None Depth to top Bottom Total Depth of Well 3341 Feet  
Show depth and thickness of all water, oil and gas formations.

OIL, GAS OR WATER RECORDS

CASING RECORD

FORMATION	CONTENT	FROM	TO	SIZE	PUT IN	PULLED OUT
				8-5/8	262	None

Describe in detail the manner in which the well was plugged, indicating where the mud fluid was placed and the method or methods used in introducing it into the hole. If cement or other plugs were used, state the character of same and depth placed, from feet to feet for each plug set.

Mud to 265 ft. with plug and 1/4 sack of hulls, 25 sacks cement. Mud to 40 ft. plug and bridge to hold Kelly, 10 sacks cement, 2 sacks cement in rat hole.

RECEIVED  
STATE CORPORATION COMMISSION  
JUL 25 1972  
CONSERVATION DIVISION  
Wichita, Kansas

(If additional description is necessary, use BACK of this sheet)  
Name of Plugging Contractor: Gabbert-Jone Drilling Company  
Address: Wichita, Kansas

STATE OF Kansas, COUNTY OF Sedgwick, ss.  
Leo Newlin (employee of owner) or (owner) of the above-described

well, being first duly sworn on oath, says: That I have knowledge of the facts, statements, and matters herein contained and the log of the above-described well as filed and that the same are true and correct. So help me God.

(Signature) Leo Newlin  
809 Petroleum Bldg Wichita 67202  
(Address)

SUBSCRIBED AND SWORN to before me this 24th day of July, 1972

My commission expires October 30, 1975  
Virginia Parker  
Notary Public.

GABBERT-JONES, INC.  
WICHITA, KANSAS  
DRILLERS' WELL LOG

RECEIVED  
STATE CORPORATION COMMISSION  
JUL 25 1972  
CONSERVATION DIVISION  
Wichita, Kansas

SHEPHERD #1  
1320' E of WL  
440' N of SL  
NE/4 Section 32-20S-9W  
Rice County, Kansas

Commenced: May 11, 1972  
Completed: May 18, 1972

OPERATOR: ALADDIN PETROLEUM CORP.

Depth		Formation	Remarks
From	To		
0	90	Sand-clay	Ran 6 joints of used 28# 8 5/8" csg. set @ 262 cement w/250 ska common 3% CC - 2% Gel Cement Circ. P.D. 5:15 PM 5/11/72
90	270	Shale-redbed	
270	1135	Shale	
1135	1461	Shale w/lime	
1461	2085	Lime-shale	
2085	2490	Shale-lime	
2490	2950	Lime-shale	
2950	3275	Lime	
3275	3341	Lime-shale-sand	
3341	ID		

I, James S. Sutton, II, certify this is a correct copy of the Drillers' Log for the well drilled in the NE/4 fo Section 32-20S-9W, Rice County, Kansas, to the best of my knowl-dge and belief.

*James S. Sutton, II*  
James S. Sutton, II

STATE OF KANSAS     )  
                              ) SS  
COUNTY OF SEDGWICK )

Before me, the undersigned, a Notary Public within and for said County and State, on this 24th day of May, 1972, personally appeared James S. Sutton, II to me personally known to be the identical person who executed the within and foregoing instrument and acknowledged to me that he executed the same as his free and voluntary act and deed for the uses and purposes therein set forth.

IN WITNESS WHEREOF, I have hereunto set my hand and official seal the day and year last above written.

*Marjorie Hall*  
Marjorie Hall, Notary Public

My Commission  
expires November 29, 1975