

STATE OF KANSAS
STATE CORPORATION COMMISSION

WELL PLUGGING RECORD


OR

FORMATION PLUGGING RECORD

Strike out upper line
when reporting plug-
ging off formations.

Give All Information Completely
Make Required Affidavit
Mail or Deliver Report to:
Conservation Division
State Corporation Commission
800 Bittling Building
Wichita, Kansas

Rice County. Sec. 11 Twp. 20S. Rge. (E) 9 (W)
Location as "NE 1/4 NW 1/4 SW 1/4" or footage from lines SW SW SW
Lease Owner Hinkle Oil Company and Franco Central
Lease Name Minor Well No. 1
Office Address 919 Union National Bank Bldg., Wichita, Kansas.
Character of Well (completed as Oil, Gas or Dry Hole) D & A
Date well completed September 29 1945
Application for plugging filed Sept 30, 1945 19
Application for plugging approved Sept. 30, 1945 19
Plugging commenced Sept 30, 1945 19
Plugging completed Sept 30, 1945 19
Reason for abandonment of well or producing formation

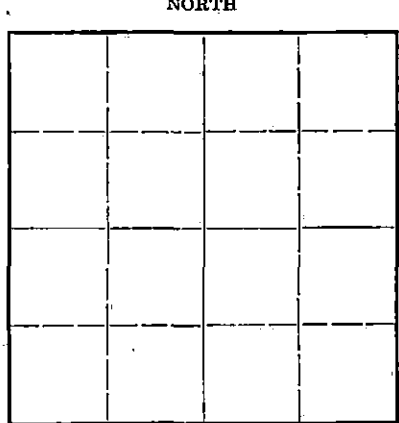

Locate well correctly on above
Section Flat

If a producing well is abandoned, date of last production 19
Was permission obtained from the Conservation Division or its agents before plugging was com-
menced? H. W. Kerr, Great Bend, Kansas.
Name of Conservation Agent who supervised plugging of this well H. W. Kerr
Producing formation Depth to top Bottom Total Depth of Well Feet
Show depth and thickness of all water, oil and gas formations.

OIL, GAS OR WATER RECORDS

CASING RECORD

Formation	Content	From	To	Size	Put In	Pulled Out
					200'	10" none

Describe in detail the manner in which the well was plugged, indicating where the mud fluid was placed and the method or methods used in introducing it into the hold. If cement or other plugs were used, state the character of same and depth placed, from feet to feet for each plug set.
Filled with mud to 180'
Set plug at 180'
Cemented with 15 sax cement
Filled with mud to 20'
Set plug at 20'
Cemented with 10 sax cement.

Stamp: 11-20-1945
Stamp: 28. inc 2

Stamp: 10-6-1945
Stamp: STATE CORPORATION COMMISSION
Stamp: OCT 6 - 1945
Stamp: CONSERVATION DIVISION

(If additional description is necessary, use BACK of this sheet)
Correspondence regarding this well should be addressed to Hinkle Oil Company
Address 919 Union National Bank Bldg., Wichita, Kansas.

STATE OF Kansas, COUNTY OF Sedgwick, ss.
J. B. Hinkle (employer of user or owner operator) of the above-described well,

being first duly sworn on oath, says: That I have knowledge of the facts, statements, and matters herein contained and the log of the above-described well as filed and that the same are true and correct. So help me God.

(Signature) J. B. Hinkle
919 Union National Bank Bldg., Wichita, Kansas.
(Address)

SUBSCRIBED AND SWORN to before me this 5th day of October, 1945

Margaret P. Upton
Notary Public.

My commission expires 1-17-46

Casing record.
200' 10"

Minor No. 1. SE 3/4 SW 11-20N-9E, Rice County, Kansas.
Franco Central and Hinkle Oil Company
Contractors: J. B. Hinkle.
Comm. 9-16-45 Comp. 9-28-45
Elevation 1804

0	60	Sand
60	175	Shale and shells
175	199	Shale
199	1695	Shale and shells
1655	1945	Sandy lime
1945	2590	Shale and shells
2530	2550	lime
2550	2655	Shale and shells
2655	2669	Shale
2669	2745	lime
2745	2775	lime and shale
2775	2920	lime
2920	3095	lime and shale
3095	3320	lime
3320	3350	shale and lime
3350	3359	Sand
3359	3395	Shale
3395	3408	Artucial dolomite.

Top:	
K. C.	3067
Base K.O.	3323
Comp.	3350
Arb.	3395

State of Kansas. }
County of Sedgwick. } ss.

I hereby certify that the above is a true and correct log as compiled from the daily drilling reports kept at said well.

J.B. Hinkle

Subscribed to and sworn to before me this 4th day of October, 1945.

Murphy A. Kipton
Notary Public.

My commission expires 1-17-46.

STATE OF KANSAS
COMMISSIONER
OCT 6 - 1945
CONSERVATION
DIVISION

LOGGING
FILE 11 20 100
BOOK PAGE 28 LINE 2