

STATE OF KANSAS
STATE CORPORATION COMMISSION

WELL PLUGGING RECORD


251

Give All Information Completely
Make Required Affidavit
Mail or Deliver Report to:
Conservation Division
State Corporation Commission
800 Bittling Building
Wichita, Kansas

OR
FORMATION PLUGGING RECORD

Strike out upper line
when reporting plugging
of formations.

NORTH

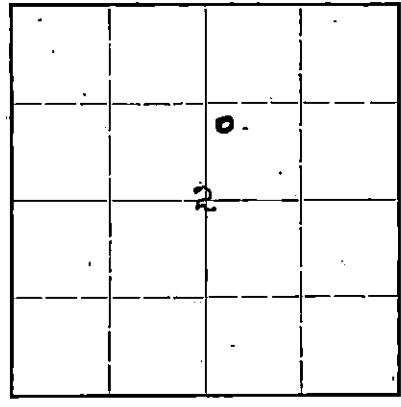

Locate well correctly on above
Section Plat

Pawnee County. Sec. 2 Twp. 20 Rge. 16 (W) (W)

Location as "NE 1/4 NW 1/4 SW 1/4" or footage from line N.W. C-S.W.-N.E

Lease Owner Bird & Shelly

Lease Name Wichita 13 acres Well No. 2

Office Address Wichita 13 acres

Character of Well (completed as Oil, Gas or Dry Hole) Dry hole skidded

Date well completed 5-31 1945

Application for plugging filed 5-31 1945

Application for plugging approved 5-31 1945

Plugging commenced 5-31 1945

Plugging completed 5-31 1945

Reason for abandonment of well or producing formation post-the-hole and could not complete

If a producing well is abandoned, date of last production 19

Was permission obtained from the Conservation Division or its agents before plugging was commenced? yes

Name of Conservation Agent who supervised plugging of this well Yes

Producing formation Depth to top Bottom Total Depth of Well 2823 Feet


Show depth and thickness of all water, oil and gas formations.

OIL, GAS OR WATER RECORDS				CASING RECORD		
Formation	Content	From	To	Size	Put In	Pulled Out
				8 3/8	10 15	none

Describe in detail the manner in which the well was plugged, indicating where the mud fluid was placed and the method or methods used in introducing it into the hold. If cement or other plugs were used, state the character of same and depth placed, from feet to feet for each plug set.

Well was plugged with heavy rotary mud from 2823' to 250' cement plug from 250' to 190' spotted by Halibuster rotary cement from 190' to 30' cement plug from 30' to 5' bottom of cellar

Cement was introduced to hole through drill pipe

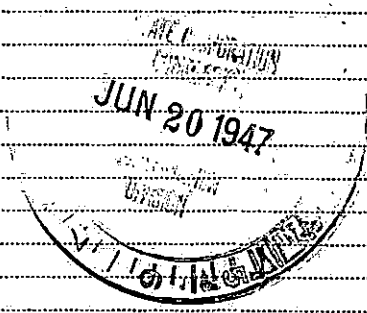

(If additional description is necessary, use BACK of this sheet)

Correspondence regarding this well should be addressed to Bird & Shelly at Wichita Kans
Address

STATE OF Kansas COUNTY OF Sedgwick, ss.

W. B. Campbell ~~Employer or owner or operator~~ of the above-described well, being first duly sworn on oath, says: That I have knowledge of the facts, statements, and matters herein contained and the log of the above-described well as filed and that the same are true and correct. So help me God.

(Signature) W. B. Campbell

403 Union National Bank Building
Wichita, Kans (Address)

SUBSCRIBED AND SWORN to before me this 6th day of June, 1945

My commission expires June 23, 1948

Leota Foreman Notary Public.

PLUGGING
FILE SEC 2 T 20 R 16W
BOOK PAGE 15 LINE 5