


STATE OF KANSAS  
STATE CORPORATION COMMISSION

WELL PLUGGING RECORD

Give All Information Completely  
Make Required Affidavit  
Mail or Deliver Report to:  
Conservation Division  
State Corporation Commission  
800 Bitting Building  
Wichita, Kansas

Pawnee County, Sec. 2 Twp. 20S Rge. 16W (E) (W)

Location as "NE/CNW/SW" or footage from lines NW NW NE  
Lease Owner J. W. Bird  
Lease Name J. J. Dirks Well No. 1  
Office Address 28 Kennedy Street, Bradford, Pennsylvania  
Character of Well (completed as Oil, Gas or Dry Hole) abandoned oil well  
Date well completed May 9, 1945 19  
Application for plugging filed February 10, 1953 19  
Application for plugging approved February 17, 1953 19  
Plugging commenced February 10, 1953 19  
Plugging completed February 13, 1953 19  
Reason for abandonment of well or producing formation oil depleted

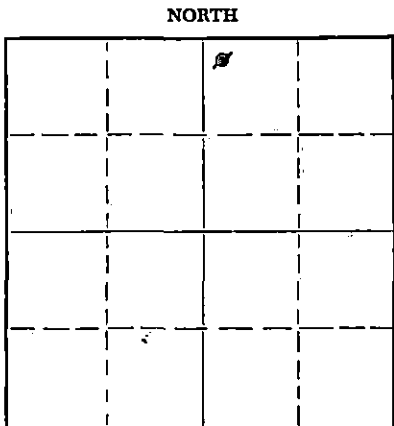

Locate well correctly on above  
Section Plat

If a producing well is abandoned, date of last production 19  
Was permission obtained from the Conservation Division or its agents before plugging was commenced? Yes

Name of Conservation Agent who supervised plugging of this well M. A. Rives  
Producing formation Depth to top Bottom Total Depth of Well 3777 Feet  
Show depth and thickness of all water, oil and gas formations.

OIL, GAS OR WATER RECORDS

CASING RECORD

FORMATION	CONTENT	FROM	TO	SIZE	PUT IN	PULLED OUT
				8-5/8"	1130'	None
				5-1/2"	3770	2597'-0"

Describe in detail the manner in which the well was plugged, indicating where the mud fluid was placed and the method or methods used in introducing it into the hole. If cement or other plugs were used, state the character of same and depth placed, from feet to feet for each plug set.

Filled hole with sand to 3760 feet and run 5 sacks of cement with dump bailer. Pulled 5-1/2 inch casing. Pumped 30 sacks jell mud. Set plug and 100 sacks of cement. Cement from 332 feet to base of cellar.

(If additional description is necessary, use BACK of this sheet)  
Name of Plugging Contractor West Supply Company  
Address Chase, Kansas

STATE OF Pennsylvania, COUNTY OF McKean, ss.  
I, J. W. Bird, (owner or operator) of the above-described well, being first duly sworn on oath, says: That I have knowledge of the facts, statements, and matters herein contained and the log of the above-described well as filed and that the same are true and correct. So help me God.

(Signature) [Signature]  
28 Kennedy St., Bradford, Pennsylvania (Address)

SUBSCRIBED AND SWORN TO before me this 21st day of April, 1953

My commission expires January 6, 1957

[Signature] Notary Public.

STATE CORPORATION COMMISSION  
24-2675-6 2-52-20M

APR 29 1953  
CONSERVATION DIVISION  
Wichita, Kansas

PLUGGING  
FILE SEC 2 T 20 R 16 W  
BOOK PAGE 79 LINE 23

4-28-1953