

15.025.20866.0000

CARD MUST BE TYPED

State of Kansas  
**NOTICE OF INTENTION TO DRILL**  
(see rules on reverse side)

CARD MUST BE SIGNED

Starting Date: ..... January 15, 1985  
month day year

API Number 15- 025-20,866

**OPERATOR:** License # 5762  
Name Hadson Petroleum Corporation  
Address P.O. Box 26770  
City/State/Zip Okla. City, Okla. 73126  
Contact Person Curt Harris  
Phone 405/235/9531 x316

C 1/2 S. 1/4 SE (location) Sec. 7. Twp. 30. S, Rge. 21  East  West

990 Ft North from Southeast Corner of Section  
1980 Ft West from Southeast Corner of Section  
(Note: Locate well on Section Plat on reverse side)

**CONTRACTOR:** License # 5420  
Name White & Ellis  
City/State 401 E. Douglas Wichita, Ks. 67202

Nearest lease or unit boundary line 990 feet.  
County Clark  
Lease Name Jantzen Well# 1-7

Domestic well within 330 feet:  yes  no  
Municipal well within one mile:  yes  no

**Well Drilled For:**  Oil  Swd  Infield  Mud Rotary  
 Gas  Inj  Pool Ext.  Air Rotary  
 OWWO  Expl  Wildcat  Cable

Depth to Bottom of fresh water ..... feet  
Lowest usable water formation Permian  
Depth to Bottom of usable water 200 feet

If OWWO: old well info as follows:  
Operator .....  
Well Name .....  
Comp Date ..... Old Total Depth .....  
Projected Total Depth 5450 feet  
Projected Formation at TD MORROW  
Expected Producing Formations MORROW

Surface pipe by Alternate: 1  2   
Surface pipe to be set 200 feet  
Conductor pipe if any required N/A feet  
Ground surface elevation 2389 feet MSL  
This Authorization Expires 5-29-85  
Approved By 11-29-84 [Signature]

I certify that we will comply with K.S.A. 55-101, et seq., plus eventually plugging hole to K.C.C. specifications.

Date 11/28/84 Signature of Operator or Agent


[Signature] Title VP

MHC/KRONE 11/29/84

Must be filed with the K.C.C. five (5) days prior to commencing well  
This card void if drilling not started within six (6) months of date received by K.C.C.

**Important procedures to follow:**

**A Regular Section of Land**  
**1 Mile = 5,280 Ft.**

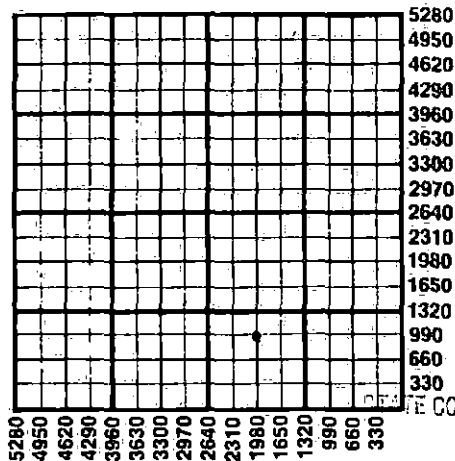

1. Notify District office before setting surface casing.
2. Set surface casing by circulating cement to the top.
3. File completion forms ACO-1 with K.C.C. within 90 days of well completion, following instructions on ACO-1, side 1, and including copies of wireline logs.
4. Notify District office 48 hours prior to old well workover or re-entry.
5. Prior to plugging, prepare a plugging plan, then obtain agreement from the appropriate district office for an approved plugging plan.
6. Submit plugging report (CP-4) to K.C.C. after plugging is completed.
7. Obtain an approved injection docket number before disposing of salt water.
8. Notify K.C.C. within 10 days when injection commences or terminates.
9. If an alternate 2 completion, cement in the production pipe from below any usable water to surface within 120 days of spud date.

RECEIVED  
STATE CORPORATION COMMISSION

NOV 29 1984  
11-29-84  
CONSERVATION DIVISION  
Wichita, Kansas

State Corporation Commission of Kansas  
Conservation Division  
200 Colorado Derby Building  
Wichita, Kansas 67202  
(316) 263-3238