

STATE OF KANSAS
STATE CORPORATION COMMISSION


WELL PLUGGING RECORD

Give All Information Completely
Make Required Affidavit
Mail or Deliver Report to:
Conservation Division
State Corporation Commission
800 Biting Building
Wichita, Kansas

Barton County. Sec. 8 Twp. 20 Rge. 12 (E) W (W)

Location as "NE/CNW'SW" or footage from lines NE NE SW
Lease Owner Hilton Drilling Company, Inc.
Lease Name Weber Well No. 1
Office Address 2121 Tenth Street, Great Bend, Kansas
Character of Well (completed as Oil, Gas or Dry Hole) dry hole
Date well completed March 8 19 54
Application for plugging filed March 17 19 54
Application for plugging approved March 18 19 54
Plugging commenced March 19 19 54
Plugging completed March 23 19 54
Reason for abandonment of well or producing formation dry hole

NORTH

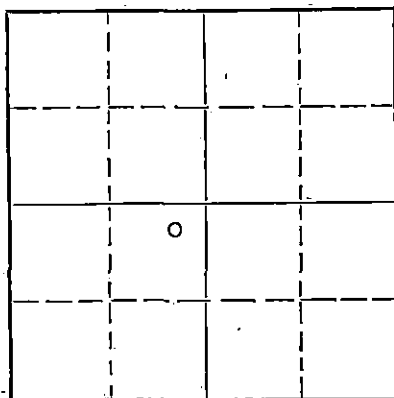

Locate well correctly on above
Section Flat

If a producing well is abandoned, date of last production _____ 19 ____
Was permission obtained from the Conservation Division or its agents before plugging was commenced? yes

Name of Conservation Agent who supervised plugging of this well W. H. Horner
Producing formation _____ Depth to top _____ Bottom _____ Total Depth of Well 3500 Feet
Show depth and thickness of all water, oil and gas formations.

OIL, GAS OR WATER RECORDS

CASING RECORD

FORMATION	CONTENT	FROM	TO	SIZE	PUT IN	PULLED OUT
		0	141	8 5/8	141	none
			3499	5 1/2	3499	2772' 1"

Describe in detail the manner in which the well was plugged, indicating where the mud fluid was placed and the method or methods used in introducing it into the hole. If cement or other plugs were used, state the character of same and depth placed, from _____ feet to _____ feet for each plug set.
Plugged 5 1/2" back to 3245' with crushed rock. Mixed and dumped 5 sx. cement. Used Sun Cementing Co. pumphtruck to plug the surface; using 15 sx. mud. Put in plug and mixed and pumped 75 sx. cement.

(If additional description is necessary, use BACK of this sheet)
Name of Plugging Contractor Ace Pipe Pulling Co.
Address P. O. Box 304, Great Bend, Kansas

STATE OF KANSAS, COUNTY OF BARTON, ss.
Henry Peacock, Secretary, (employee of owner) or (owner or operator) of the above-described well, being first duly sworn on oath, says: That I have knowledge of the facts, statements, and matters herein contained and the log of the above-described well as filed and that the same are true and correct. So help me God.

(Signature) Henry Peacock Secretary
2421 Tenth Street, Great Bend, Kansas
(Address)

SUBSCRIBED AND SWORN TO before me this 26th day of March, 19 54
Margaret Whitmore
Notary Public.

My commission expires April 4, 1956.
24-7366-5 3-53-20M

PLUGGING
BOOK PAGE 20 LINE 26

RECEIVED
STATE CORPORATION COMMISSION
MAR 26 1954 3-26-54
CONSERVATION DIVISION
Wichita, Kansas

DRILLER'S LOG

COMPANY: Hilton Drilling Company, Inc. LOCATION: NE NE SW 8-20-12W
 Barton County
 CONTRACTOR: Hilton Drilling Company, Inc. Kansas
 FARM NAME: Weber ELEVATION: 1863 KB
 COMMENCED: 2-24-54 CASING USED: 8-5/8" @ 141' w/200 sx.
 COMPLETED: 3-9-54


Clay and sand	40
Sand, Gravel & clay	120
Hard Sand & Clay	135
Hard Sand	147
Sand and Clay	175
Hard Sand	180
Sand, Iron & Shale	185
Shale, Shells - Iron Streaks	270
Sand & Shale	325
Red Bed, Sand & Shale	660
Anhydrite	690
Shale & Shells	910
Shale, Shells & Salt	1305
Lime & Shale	1475
Broeken Lime	1600
Lime & Shale	1760
Lime	1870
Sand	1890
Lime & Shale	2720
Lime	3101
Shale & Lime	3187
Lime	3438
Conglomerate	3450
Lime	3500
TD	3500

TOPS

Heebner	3067	-1204
Douglas	3101	-1238
Br. Lime	3187	-1324
Lansing	3202	-1329
Arbuckle	3450	-1587

STATE OF KANSAS)
) ss.
 COUNTY OF BARTON)

I, the undersigned, being duly sworn on oath, state that the above statement and log are true and a correct record and log of the well drilled at the location above described.

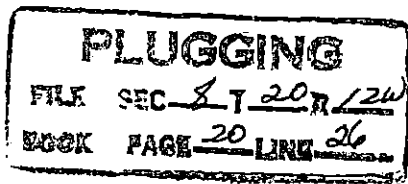

HILTON DRILLING COMPANY, INC.

Henry Peacock
 Henry Peacock, Secretary

Subscribed and sworn to before me this 17th day of March, 1954

Margaret Whitman
 Notary Public

FILED
 MAR 13 1954
 MINERALS DIVISION
 Kansas