


WELL PLUGGING RECORD

Give All Information Completely
Make Required Affidavit
Mail or Deliver Report to:
Conservation Division
State Corporation Commission
800 Hitting Building
Wichita, Kansas

Barton County. Sec. 8 Twp. 20 Rge. 12 (E) W (W)
Location as "NE/CNW/SW" or footage from lines C E/2 SE/4

Lease Owner B. E. Ash
Lease Name Tonkin "A" Well No. 2
Office Address Box 247 Ellinwood, Kansas
Character of Well (completed as Oil, Gas or Dry Hole) Dry hole.
Date well completed March 22, 1960
Application for plugging filed Called Donal Truan 3/21 19 60
Application for plugging approved 3/21 19 60
Plugging commenced 3/22 19 60
Plugging completed 3/22 19 60
Reason for abandonment of well or producing formation D&A

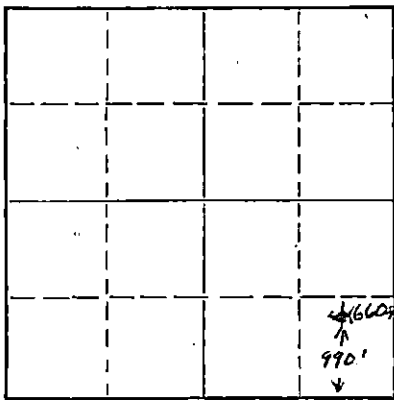

Locate well correctly on above
Section Plat

If a producing well is abandoned, date of last production _____ 19 ____
Was permission obtained from the Conservation Division or its agents before plugging was commenced? Yes

Name of Conservation Agent who supervised plugging of this well Donal Truan
Producing formation _____ Depth to top _____ Bottom _____ Total Depth of Well 3476 Feet
Show depth and thickness of all water, oil and gas formations.

OIL, GAS OR WATER RECORDS

CASING RECORD

FORMATION	CONTENT	FROM	TO	SIZE	PUT IN	PULLED OUT
Surface Casing		0	229.0'	8 5/8"		none
(cemented with 145 sacks cement, 2 sacks calcium chloride.)						

Describe in detail the manner in which the well was plugged, indicating where the mud fluid was placed and the method or methods used in introducing it into the hole. If cement or other plugs were used, state the character of same and depth placed, from _____ feet to _____ feet for each plug set.

Hole filled w/ heavy mud w/drill pipe to 200'
Halliburton plug to 200'
Dumped 1/2 sack hulls, 25 sacks cement with drill pipe.
Mudded to 40'
Dumped 1/2 sack hulls.
Dumped 10 sacks cement. Also dumped 2 sacks cement in rat hole and shoveled full of sand.

RECEIVED
STATE CORPORATION COMMISSION

MAR 29 1960

CONSERVATION DIVISION
Wichita, Kansas

(If additional description is necessary, use BACK of this sheet)
Name of Plugging Contractor Bea Drilling Company
Address Box 247, Ellinwood, Kansas

STATE OF Kansas, COUNTY OF Barton, ss.
I, C. F. Krehbiel (employee of owner) or (owner or operator) of the above-described well, being first duly sworn on oath, says: That I have knowledge of the facts, statements, and matters herein contained and the log of the above-described well as filed and that the same are true and correct. So help me God.

(Signature) C. F. Krehbiel
Box 247, Ellinwood, Kansas
(Address)

SUBSCRIBED AND SWORN TO before me this 28 day of March, 19 60

R. J. ARBUTHNOT, NOTARY PUBLIC
MY COMMISSION EXPIRES JULY 6, 1966
My commission expires _____

[Signature]
Notary Public.

WELL LOG

15.009.05232.0000

Company: B. E. Ash, Box 247, Ellinwood, Kansas

Location: #2 Tonkin, 990' North of South Line, 660' West of East Line.
E/2 SE/4 Sec. 8; Twp. 20S; Rge. 12W Barton County, Kansas

Contractor: Bea Drilling Company, Box 247, Ellinwood, Kansas

Date Started: 3/12/60 Elevation: 1843 K.B. 1840 D.F.

Date Completed: 3/22/60

Casing Record: 8 5/8" casing set @ 229'. Cemented w/ 145 sacks, 2 C.C.

LOG

(Measurements from top of rotary bushing to bottom of formation.)

Surface sand and clay	140
Shale & shells	380
Red bed	650
Anhydrite	670
Shale & red bed	1220
Shale & salt	1230
Shale	1570
Shale & Lime	2730
Lime & Shale	3155
Lime	3476 Rot. T. D.

VED
COMMISSION
MAR 29 1960
CONSERVATION DIVISION
Wichita, Kansas

The undersigned, C. F. Krehbiel, partner, Bea Drilling Company, hereby certifies that the above log is a true and correct log of formations encountered in drilling the above well as reflected by the daily drilling reports.

Bea Drilling Company

by C. F. Krehbiel

Subscribed and Sworn to before me this 28 day of March 1960.

[Signature]
Notary Public

My commission expires _____

F. J. ARBUTHNOT NOTARY PUBLIC
MY COMMISSION EXPIRES JULY 6, 1960