

Give All Information Completely
Make Required Affidavit
Mail or Deliver Report to:
Conservation Division
State Corporation Commission
211 No. Broadway
Wichita, Kansas

WELL PLUGGING RECORD

Barton County, Sec. 8 Twp. 20 Rge. 12 (E) W (W)

Location as "NE/CNW/SW" or footage from lines 100' W of NW NE NE

Lease Owner Oscar L. Stutenroth

Lease Name Lanterman Well No. 1

Office Address 400 Pembroke Lane, Ellinwood, Kansas

Character of Well (completed as Oil, Gas or Dry Hole) Dry hole

Date well completed 3/21/63 1963

Application for plugging filed Verbally, 3/21/63 1963

Application for plugging approved Verbally, 3/21/63 1963


Plugging commenced 1 A.M. 3/22/63 1963

Plugging completed 4 A.M. 3/22/63 1963

Reason for abandonment of well or producing formation Dry hole

If a producing well is abandoned, date of last production _____ 1963

Was permission obtained from the Conservation Division or its agents before plugging was commenced? Yes

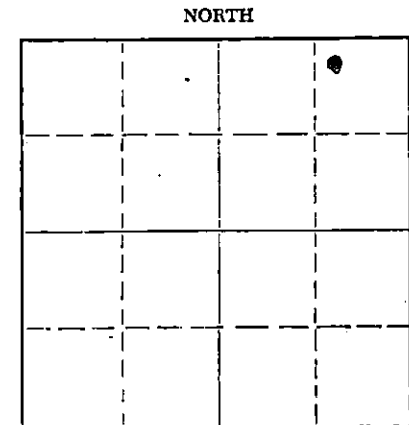

Locate well correctly on above Section Plat

Name of Conservation Agent who supervised plugging of this well Don Truan, Russell, Kansas

Producing formation _____ Depth to top _____ Bottom _____ Total Depth of Well 3469 Feet

Show depth and thickness of all water, oil and gas formations.

OIL, GAS OR WATER RECORDS

CASING RECORD

FORMATION	CONTENT	FROM	TO	SIZE	PUT IN	PULLED OUT
		0	207	8 5/8"	207	none

Describe in detail the manner in which the well was plugged, indicating where the mud fluid was placed and the method or methods used in introducing it into the hole. If cement or other plugs were used, state the character of same and depth placed, from _____ feet to _____ feet for each plug set.

Mudded from 3469 to 200'
Set plug @200' plus 1/2 sack hulls,
Run 25 sacks cement,
Mudded to 41'
Set plug @40' plus 1/2 sack hulls,
Run 10 sacks cement, filled to bottom of cellar.
Run 2 sacks in rathole, filled w/soil.

RECEIVED
STATE CORPORATION COMMISSION

APR 9 1963

CONSERVATION DIVISION
Wichita, Kansas

(If additional description is necessary, use BACK of this sheet)
Name of Plugging Contractor Bea Drilling Co., Inc.
Address Box 247, Ellinwood, Kansas

STATE OF Kansas, COUNTY OF Barton, ss.
C. F. Krehbiel (employee of owner) or (owner or operator) of the above-described

well, being first duly sworn on oath, says: That I have knowledge of the facts, statements, and matters herein contained and the log of the above-described well as filed and that the same are true and correct. So help me God.

(Signature) C. F. Krehbiel
Box 247, Ellinwood, Kansas
(Address)

SUBSCRIBED AND SWORN TO before me this 5th day of April, 1963

My commission expires August 16, 1966
Keith Rickert Notary Public

OSCAR L. STUTENROTH

15.009.05233.0000

et al

Lanterman #1

100 ft west of

NW NE NE Section 8-20S-12W

Barton County, Kansas

Contr: Bea Drilling Co., Inc.
Box 247, Ellinwood, Ks.

Staked: 3/9/63
Started: 3/13/63
Completed: 3/22/63

Elevation: 1822' GR 1827' KB

Casing Record: 10 jts, 207.54' of
28# 8 5/8" casing, cemented w/140
sacks 12 hr cement, 1 aquagel, circ-
ulated w/20' in casing. Plug down,
3 A.M. 3/14/63

Tops:		
Heebner	3023	-1196
Toronto	3042	-1215
Douglas	3056	-1229
Brown lime	3138	-1311
Lansing-K.C.	3153	-1326
Conglomerate	3399	-1472
Arbuckle	3406	-1579

Drill Stem TESTS: #1

3280-3296 Open 1 hr, weak blow 50 min., recovered 30' of water cut mud.
No show of oil. 20 min IBHP 1138#; 20 min FBHP 1080#; IFP 22#; FFP 22#.

#2

3409-3421 Open 30 min, weak blow 9 min. recovered 5' of mud, one pint of
heavy oil in top of tool. 20 min IBHP 771#; 20 min FBHP 487#; IFP 12# FFP 12#

Drillers Log

(All measurements to bottom of formation.)

Surface sand, pyrites	165
Blue shale	205
Shale & sand	645
Anhydrite	670
Shale & red bed	800
Shale & shells	1480
Sdy lime & shale	1590
Shale & lime	1735
Lime & shale	1880
Shale & lime	2830
Lime	2890
Lime & shale	3170
Shale & lime	3214
Lime	3296
Shale & lime	3390
Lime	3469
Rotary total depth	3469

RECEIVED
STATE CORPORATION COMMISSION

APR 9 1963

CONSERVATION DIVISION
Wichita, Kansas

I hereby certify that the above is a true and correct log of
said well as reflected by the daily drilling reports.

C. F. Krehbiel
C. F. Krehbiel, Vice-Pres.
Bea Drilling Co., Inc. (contr)

STATE OF KANSAS, COUNTY OF BARTON, ss

Subscribed and sworn to before me this 5th day of April, 1963.

Notary Public
Notary Public

My commission expires August 16, 1966.