


STATE OF KANSAS
STATE CORPORATION COMMISSION
Give All Information Completely
Make Required Affidavit
Mail or Deliver Report to:
Conservation Division
State Corporation Commission
212 North Market, Insurance Bldg.
Wichita, Kansas

WELL PLUGGING RECORD

Barton County, Sec. 13 Twp. 20 Rge. (E) 14 (W)
Location as "NE/CNW/SW" or footage from lines NW SE SE NE
Lease Owner Great Bend Pipe and Supply
Lease Name Titus Well No. 1
Office Address Great Bend, Kansas
Character of Well (completed as Oil, Gas or Dry Hole) Oil
Date well completed _____ 19____
Application for plugging filed _____ 19____
Application for plugging approved _____ 19____
Plugging commenced 3-28 19 61
Plugging completed 3-31 19 61
Reason for abandonment of well or producing formation _____

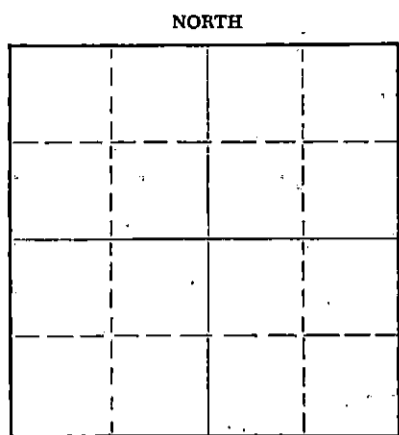

Locate well correctly on above Section Plat

If a producing well is abandoned, date of last production _____ 19____
Was permission obtained from the Conservation Division or its agents before plugging was commenced? Yes

Name of Conservation Agent who supervised plugging of this well Donald Truan
Producing formation _____ Depth to top _____ Bottom _____ Total Depth of Well 3601 Feet
Slow depth and thickness of all water, oil and gas formations.

OIL, GAS OR WATER RECORDS

CASING RECORD

FORMATION	CONTENT	FROM	TO	SIZE	PUT IN	PULLED OUT
				8 5/8	799'	NONE
				4 1/2	3601'	1994'

Describe in detail the manner in which the well was plugged, indicating where the mud fluid was placed and the method or methods used in introducing it into the hole. If cement or other plugs were used, state the character of same and depth placed, from _____ feet to _____ feet for each plug set.

Lane Wells Plugging Co. @ 3412'
Top perforation @ 3389'

Sanded hole to 3380' - dumped 4 sks cement - pulled pipe - mudded hole to 300' - set 10' rock bridge - dumped 25 sks cement - mudded to 40' - set 10' rock bridge - dumped 10 sks cement

RECEIVED
STATE CORPORATION COMMISSION
MAY 15 1961
CONSERVATION DIVISION
Wichita, Kansas

(If additional description is necessary, use BACK of this sheet) 5-15-61
Name of Plugging Contractor _____
Address _____

STATE OF Kansas, COUNTY OF Barton, ss.
Nathan Meltzer (employee of owner) or (~~owner or operator~~) of the above-described well, being first duly sworn on oath, says: That I have knowledge of the facts, statements, and matters herein contained and the log of the above-described well as filed and that the same are true and correct. So help me God.

(Signature) Nathan Meltzer
Drawer "B" Great Bend, Kansas
(Address)

SUBSCRIBED AND SWORN TO before me this 12th day of May, 19 61

My commission expires 3/31/65

Gene Meltzer Notary Public.

15.009.14794.0000

DRILLER'S LOG

COMPANY: LEBEN DRILLING, INC. AND R. S. C. OIL CO.
 CONTRACTOR: LEBEN DRILLING, INC.
 FARM: TITUS #1
 LOCATION: NW SE NE SEC. 13-20-14
 BARTON COUNTY, KANSAS
 COMMENCED: 11-25-57
 COMPLETED: 12-7-57

0	190	Sand	
190	400	Shale & Sand	TOPS:
400	470	Shale & Shells	
470	790	Sand, Shale & Red Bed	ANHYDRITE 793
790	895	Shale & Lime	HEEBNER 3132 (-1244)
895	1670	Shale & Shells	TORONTO 3146 (-1258)
1670	1985	Lime & Shale	DOUGLAS 3159 (-1271)
1985	2180	Lime	BR. LIME 3232 (-1344)
2180	2650	Shale & Lime	LANSING 3248 (-1360)
2650	2900	Shale & Lime	B/K.C. 3467 (-1579)
2900	3125	Lime	ARBUCKLE 3504 (-1616)
3125	3245	Lime & Shale	RTD 3602 (-1714)
3245	3410	Lime	
3410	3585	Lime	ELEVATION 1888 K.B.
3585	3602	Lime	
	3602	<u>Rotary Total Depth</u>	

Set 799' of 8 5/8" surface casing with 450 sacks cement and 5 sacks gel. and 2% CaCl.

I, Frank Hamlin, do hereby certify that the above and foregoing is a true and correct copy of the log of the Titus #1, located NW SE NE of Section 13, Township 20 South, Range 14 West, Ellis County, Kansas, as reflected by the files of Leben Drilling, Inc.

LEBEN DRILLING, INC.

RECEIVED
STATE CORPORATION COMMISSION

By:

Frank Hamlin
Frank Hamlin

MAR 29 1961

STATE OF KANSAS)
COUNTY OF SEDGWICK)

SS CONSERVATION DIVISION
Wichita, Kansas

Subscribed and sworn to before me, a Notary Public, in and for Sedgwick County, Kansas, this 10th day of December, 1957.

Ruth N. Benjamin
Ruth N. Benjamin, Notary Public

My Commission Expires:

June 17, 1961.