


STATE OF KANSAS  
STATE CORPORATION COMMISSION  
Give All Information Completely  
Make Required Affidavit  
Mail or Deliver Report to:  
Conservation Division  
State Corporation Commission  
211 No. Broadway  
Wichita, Kansas

Form CP-4

WELL PLUGGING RECORD

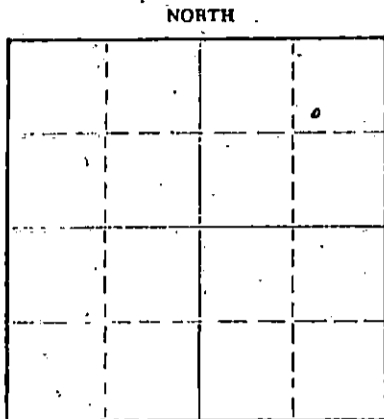

Locate well correctly on above Section Plot

Barton County, Sec. 13 Twp. 20S Rge. 14 (E) 14 (W)  
Location as "NE/CNW/SW" or footage from lines SW NE NE  
Lease Owner Kansas Exploration Company  
Lease Name Stolz Well No. 1  
Office Address 232 Bonnie Brae, Wichita, Kansas  
Character of Well (completed as Oil, Gas or Dry Hole) oil  
Date well completed \_\_\_\_\_ 19\_\_\_\_  
Application for plugging filed July 14 1964  
Application for plugging approved \_\_\_\_\_ 19\_\_\_\_  
Plugging commenced July 15 1964  
Plugging completed July 27 1964  
Reason for abandonment of well or producing formation depleted

If a producing well is abandoned, date of last production \_\_\_\_\_ 19\_\_\_\_  
Was permission obtained from the Conservation Division or its agents before plugging was commenced? yes

Name of Conservation Agent who supervised plugging of this well Donald Truan  
Producing formation \_\_\_\_\_ Depth to top \_\_\_\_\_ Bottom \_\_\_\_\_ Total Depth of Well 3625 Feet  
Show depth and thickness of all water, oil and gas formations.

OIL, GAS OR WATER RECORDS				CASING RECORD		
FORMATION	CONTENT	FROM	TO	SIZE	PUT IN	PULLED OUT
		0	330	8 5/8"	330	none
		0	3624	5 1/2"	3624	513.25

Describe in detail the manner in which the well was plugged, indicating where the mud fluid was placed and the method or methods used in introducing it into the hole. If cement or other plugs were used, state the character of same and depth placed, from \_\_\_\_\_ feet to \_\_\_\_\_ feet for each plug set.

Pushed plug to 3240'. Dumped 5 gallons of egg rock on plug.  
Mixed and dumped 5 sacks of cement.  
Squeezed well with Sun Oilwell Cementing pump. Used 10 sacks  
of gel and 80 sacks of cement.

RECEIVED  
STATE CORPORATION COMMISSION

AUG 4 1964

CONSERVATION DIVISION  
Wichita, Kansas

(If additional description is necessary, use BACK of this sheet)  
Name of Plugging Contractor Pipe Pullers, Inc.  
Address Box 486, Ellinwood, Kansas

STATE OF Kansas, COUNTY OF Barton, ss.  
Dean Wells (employee of owner) or (owner or operator) of the above-described well, being first duly sworn on oath, says: That I have knowledge of the facts, statements, and matters herein contained and the log of the above-described well as filed and that the same are true and correct. So help me God.

(Signature) Dean Wells  
Ellinwood, Kansas (Address)

SUBSCRIBED AND SWORN TO before me this 3 day of August, 1964

My commission expires Feb. 10, 1967  
George A. Meyer Notary Public.

CONTRACTOR'S WELL LOG

15.009.00535.000.0

COMPANY:  
CONTRACTOR:  
FARM:  
LOCATION:  
  
COMMENCED:  
COMPLETED:

LEBEN DRILLING, INC. & R.S.C. OIL COMPANY  
LEBEN DRILLING, INC.  
STOLZ #1  
SW $\frac{1}{4}$  NE $\frac{1}{4}$  NE $\frac{1}{4}$  Sec. 13-20S-14W  
BARTON COUNTY, KANSAS  
9-10-57  
9-26-57.

0	330	Shale	
330	975	Redbed & Shale	TOPS:
975	1080	Sand & Shale	
1080	1550	Shale & Shells	Heebner 3135
1560	1715	Shale & Shells	Douglas 3163
1715	2180	Lime & Shale	Brown Lime 3235
2180	2255	Lime	Lansing-K.C. 3245
2255	2320	Shale & Shells	Arbuckle 3510
2320	2470	Lime & Shale	
2470	2885	Shale & Shells	Elevation - 1689 KB
2885	3070	Shale & Lime	
3070	3205	Lime & Shale	
3205	3334	Lime	
3334	3394	Lime	
3394	3415	Lime	
3415	3465	Lime & Shale	
3465	3625	Lime	
	<u>3625</u>	<u>Rotary Total Depth</u>	

RECEIVED  
STATE CORPORATION COMMISSION  
AUG 19 1964  
CONSERVATION DIVISION  
Wichita, Kansas

Set 330' of 8 5/8" surface casing with 225 sacks cement and 4 sacks gel.

I, James M. Battin, do hereby certify that the above and foregoing is a true and correct copy of the log of the Stolz #1, located SW $\frac{1}{4}$  NE $\frac{1}{4}$  NE $\frac{1}{4}$  of Section 13, Township 20 South, Range 14 West, Barton County, Kansas, as reflected by the files of Leben Drilling, Inc.

LEBEN DRILLING, INC.

By: James M. Battin  
James M. Battin

STATE OF KANSAS )  
COUNTY OF SEDGWICK ) ss

Subscribed and sworn to before me, a Notary Public, in and for Sedgwick County, Kansas, this 23rd day of October, 1957.

Ruth N. Benjamin  
Ruth N. Benjamin, Notary Public

My Commission Expires:  
June 17, 1961.