


STATE OF KANSAS
STATE CORPORATION COMMISSION

Form CP-4

Give All Information Completely
Make Required Affidavit
Mail or Deliver Report to:
Conservation Division
State Corporation Commission
P. O. Box 17027
Wichita, Kansas 67217

WELL PLUGGING RECORD

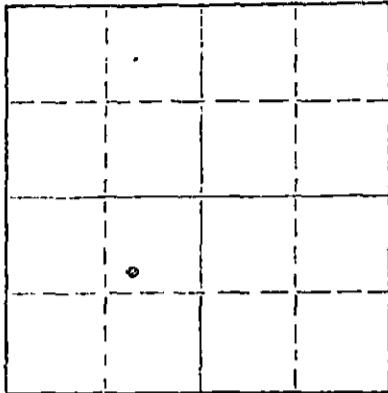

Locate well correctly on above
Section Plat

Barton County. Sec. 3 Twp. 20 Rge. (E) 12 (W)
Location as "NE/CNW/SW" or footage from lines SW NE SW
Lease Owner Petroleum, Inc.
Lease Name Southern "B" Well No. 3
Office Address Route 2, Great Bend, Kansas 67530
Character of Well (completed as Oil, Gas or Dry Hole) oil
Date well completed _____ 19____
Application for plugging filed _____ 19____
Application for plugging approved _____ 19____
Plugging commenced October 7 19 74
Plugging completed October 10 19 74
Reason for abandonment of well or producing formation depleted

If a producing well is abandoned, date of last production _____ 19____
Was permission obtained from the Conservation Division or its agents before plugging was commenced? yes

Name of Conservation Agent who supervised plugging of this well Donald Truan
Producing formation _____ Depth to top _____ Bottom _____ Total Depth of Well 3415' Feet
Show depth and thickness of all water, oil and gas formations.

OIL, GAS OR WATER RECORDS

CASING RECORD

FORMATION	CONTENT	FROM	TO	SIZE	PUT IN	PULLED OUT
			204'	8 5/8"	204'	none
			3414'	4 1/2"	3414'	3053.76

Describe in detail the manner in which the well was plugged, indicating where the mud fluid was placed and the method or methods used in introducing it into the hole. If cement or other plugs were used, state the character of same and depth placed, from _____ feet to _____ feet for each plug set.

Sanded back to 3350' and dumped 4 sacks of cement.

Sun Cementing Company plugged well pumping in 3 sacks of hulls, 20 sacks of gel and 100 sacks of cement.

RECEIVED
STATE CORPORATION COMMISSION
OCT 17 1974
CONSERVATION DIVISION
Wichita, Kansas

Name of Plugging Contractor PIPE PULLERS, INC. (If additional description is necessary, use BACK of this sheet)
Address Box 128, Ellinwood, Kansas 67526

STATE OF KANSAS COUNTY OF BARTON, ss.
Evelyn Roth (employee of owner) or (~~owner or operator~~) of the above-described

well, being first duly sworn on oath, says: That I have knowledge of the facts, statements, and matters herein contained and the log of the above-described well as filed and that the same are true and correct. So help me God.

(Signature) Evelyn Roth
Ellinwood, Kansas (Address)

SUBSCRIBED AND SWORN TO before me this 14th day of October, 19 74

JENNY KASSELMAN
NOTARY PUBLIC
BARTON COUNTY, KANSAS
MY COMM. EXP. JULY 16, 1978

Jenny Kasselmann
Notary Public.

My commission expires _____

DRILLERS' WELL LOG

DATE COMMENCED: September 7, 1974
DATE COMPLETED: September 17, 1974

PETROLEUM, INC.
Southern B #3
SW/4, NE/4 SW/4
Sec. 3-T20s-R12W
Barton County, Kansas

0 - ;80' Clay & Sand
80 - 150' Sand & Hard dry sand streaks
150 - 595' Shale
595 - 620' Anhydrite
620 - 1375' Shale
1375 - 2987' Lime & Shale
2987 - 2991' Shale
2991 - 3123' Lime & Shale
3123 - 3358' Lime
3358 - 3389' Shale & Chert
3389 - 3415' Dolomite
3415' RTD

ELEVATION: 1811 K.B.

FORMATION DATA

ANHYDRITE 595
HEEBNER 2987
BROWN LIME 3107
LANSING 3123
CONGLOMERATE 3358
AREUCKLE 3389
RTD 3415

RECEIVED
STATE CORPORATION COMMISSION

DEC 30 1974

CONSERVATION DIVISION
Wichita, Kansas

SURFACE PIPE: Set new 20#, 8-5/8"
at 204' with 180 sacks 60/40
pozmix, 2% gel, 3% cc.

PRODUCTION PIPE: Ran new 4 1/2"
casing at 3414' with 100 sacks
50/50 pozmix, 10% salt & 12
bbls. salt flush.

A F F I D A V I T

Wayne Dobbs of lawful age does swear and state that the facts and statements herein contained are true and correct to the best of his knowledge.

Wayne Dobbs

Subscribed and sworn to before me this 19 day of September 1974.

Lawrence M. Hazae
Notary Public

