


WELL PLUGGING RECORD

Give All Information Completely
Make Required Affidavit
Mail or Deliver Report to:
Conservation Division
State Corporation Commission
214 North Market, Insurance Bldg.
Wichita, Kansas

Barton County. Sec. 3 Twp. 20S Rge. 12 (E) (W)

Location as "NE/CNW/SW" or footage from lines SW NW SW
Lease Owner Strata Drilling, Inc.
Lease Name Southern Well No. 1
Office Address Post Office Box 755, Great Bend, Kansas
Character of Well (completed as Oil, Gas or Dry Hole) Dry Hole
Date well completed 9-7-60 19
Application for plugging filed 9-6-60 19
Application for plugging approved 9-6-60 19
Plugging commenced 9-6-60 19
Plugging completed 9-7-60 19
Reason for abandonment of well or producing formation Dry Hole

NORTH

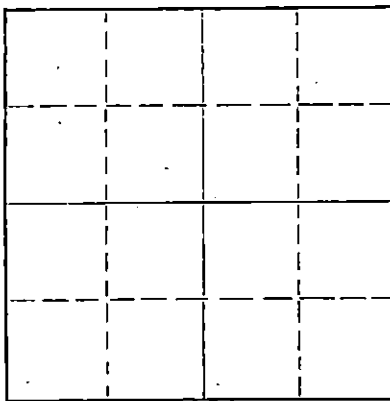

Locate well correctly on above
Section Plat

If a producing well is abandoned, date of last production _____ 19____
Was permission obtained from the Conservation Division or its agents before plugging was commenced? Yes

Name of Conservation Agent who supervised plugging of this well Donald Truan
Producing formation _____ Depth to top _____ Bottom _____ Total Depth of Well 3400 Feet
Show depth and thickness of all water, oil and gas formations.

OIL, GAS OR WATER RECORDS

CASING RECORD

FORMATION	CONTENT	FROM	TO	SIZE	PUT IN	PULLED OUT
				8 5/8"	220'	None

Describe in detail the manner in which the well was plugged, indicating where the mud fluid was placed and the method or methods used in introducing it into the hole. If cement or other plugs were used, state the character of same and depth placed, from _____ feet to _____ feet for each plug set.

1/3 of the sack of hulls, wooden plug set at 210'.
Mixed 20 sacks cement through drill pipe.

1/3 sack of hulls, wooden plug set at 40'.
Mixed 10 sacks cement.

RECEIVED
STATE CORPORATION COMMISSION

SEP 12 1960

CONSERVATION DIVISION
WICHITA, KANSAS

(If additional description is necessary, use BACK of this sheet)

Name of Plugging Contractor _____
Address _____

STATE OF Kansas, COUNTY OF Barton, ss.
V. Richard Hoover, President (employee of owner) or (owner or operator) of the above-described well, being first duly sworn on oath, says: That I have knowledge of the facts, statements, and matters herein contained and the log of the above-described well as filed and that the same are true and correct. So help me God.

(Signature) V. Richard Hoover
(Address) _____

SUBSCRIBED AND SWORN TO before me this 10th day of September, 1960

My commission expires May 19, 1962

Norris Taylor
Norris Taylor Notary Public.

WELL LOG

Strata Drilling, Inc.
P.O. Box 755
Great Bend, Kansas

#1 Southern
SW NW SW Sec. 3-20-12W
Barton County, Kansas

Contractor: Chief Drilling Co., Inc.

Commenced: 8-29-60
Completed: 9-6-60
D&A

Casing Record: 8 5/8" at 220' with 225 sacks sunset cement

RECEIVED
STATE CORPORATION COMMISSION
SEP 12 1960
CONSERVATION DIVISION

<u>FORMATION</u>	<u>From</u>	<u>To</u>	<u>ELEVATION</u>	
Sand	0	110'	1806'	Gr.
Pyrite	110'	136'	1808'	D.F.
Shale & Pyrite	136'	222'	1811'	K.B.
Shale & Shells	222'	260'		
Redbed & Shale	260'	560'		
Clay & Shale	560'	600'		
Anhydrite	600'	626'		
Shale & Shells	626'	1205'		
Shale	1205'	1400'		
Shells & Shale	1400'	1510'		
Shale	1510'	1550'		
Lime & Shale	1550'	2330'		
Shale & Lime	2330'	2719'		
Lime	2917'	2981'		
Lime & Shale	2981'	3115'		
Lime	3115'	3359'		
Conglomerate	3359'	3372'		
Dolomite	3372'	3400'		
Total Depth	3400'			

<u>FORMATION TOPS</u>	
Anhydrite	600' (+1211)
Topeka	2719' (-908)
Heebner	2981' (-1170)
Brn Lims	3100' (-1289)
Lansing	3115' (-1304)
Conglomerate	3359' (-1548)
Arbuckle	3372' (-1561)
Total Depth	3400' (-1589)

STATE OF KANSAS, COUNTY OF BARTON) SS

I hereby certify that the above is a true and correct copy of the Driller's Log of the well drilled in the SW NW SW Sec. 3-20-12W, Barton County, Kansas, to the best of my knowledge and belief.

CHIEF DRILLING CO., INC.

V. Richard Hoover
V. Richard Hoover, President

Subscribed and sworn to before me this 9th day of September, 1960.

My commission expires 5/19/62

Norris Taylor
Norris Taylor, Notary Public