


Give All Information Completely
Make Required Affidavit
Mail or Deliver Report to:
Conservation Division
State Corporation Commission
211 No. Broadway
Wichita, Kansas

WELL PLUGGING RECORD

BARTON County, Sec. 9 Twp. 20s Rge. 12w (#) (W) X

Location as "NE/CNW/SW" or footage from lines SW SE NW
Lease Owner PETROLEUM, INC.
Lease Name TONKIN "C" Well No. 1
Office Address ROUTE 2, GREAT BEND, KANSAS
Character of Well (completed as Oil, Gas or Dry Hole) DRY HOLE
Date well completed JULY 19, 19 62
Application for plugging filed JULY 19, 19 62
Application for plugging approved JULY 19, 19 62
Plugging commenced JULY 19, 19 62
Plugging completed JULY 19, 19 62
Reason for abandonment of well or producing formation NO PRODUCIBLE FORMATIONS

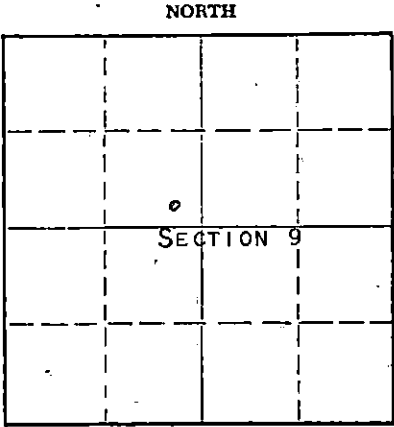

Locate well correctly on above Section Plat

If a producing well is abandoned, date of last production NONE 19
Was permission obtained from the Conservation Division or its agents before plugging was commenced? YES

Name of Conservation Agent who supervised plugging of this well MR. DONALD TRUAN
Producing formation _____ Depth to top _____ Bottom _____ Total Depth of Well 3456 Feet
Show depth and thickness of all water, oil and gas formations.

OIL, GAS OR WATER RECORDS

CASING RECORD

FORMATION	CONTENT	FROM	TO	SIZE	PUT IN	PULLED OUT
				8-5/8"	219'	NONE

Describe in detail the manner in which the well was plugged, indicating where the mud fluid was placed and the method or methods used in introducing it into the hole. If cement or other plugs were used, state the character of same and depth placed, from _____ feet to _____ feet for each plug set.

MUDDED UP WITH HEAVY MUD TO 210', FOLLOWED BY WOODEN PLUG. PLACED 20 SACKS CEMENT ONTO PLUG THROUGH DRILL PIPE. MUDDED UP WITH HEAVY MUD TO 40' FOLLOWED BY WOODEN PLUG, AND 10 SACKS CEMENT TO BASE OF WELL CELLAR. 2 SACKS CEMENT IN RAT HOLE.

RECEIVED
STATE CORPORATION COMMISSION
AUG 16 1962
CONSERVATION DIVISION
Wichita, Kansas

(If additional description is necessary, use BACK of this sheet)

Name of Plugging Contractor GARVEY DRILLING COMPANY
Address ROUTE 2, GREAT BEND, KANSAS

STATE OF KANSAS, COUNTY OF BARTON, ss.
DON SEARLE (employee of owner) or (XXXXXX XXXXXX) of the above-described well, being first duly sworn on oath, says: That I have knowledge of the facts, statements, and matters herein contained and the log of the above-described well as filed and that the same are true and correct. So help me God. DON SEARLE, DIST. PROD. SUPT.

(Signature) *Don Searle*
ROUTE 2, GREAT BEND, KANSAS
(Address)

SUBSCRIBED AND SWORN to before me this 15TH day of AUGUST, 19 62

My commission expires APRIL 14, 1963. *Arthur J. Niles* Notary Public.

WELL LOG

K.009.05236-0000

COMPANY PETROLEUM, INCORPORATED

SEC. 9 T. 20S R. 12W

FARM TONKIN "C" NO. 1

LOC. SW,SE,NW


TOTAL DEPTH 3456'

COUNTY BARTON CO., KANSAS

COMM. July 11, 1962

COMP. July 19, 1962

CONTRACTOR GARVEY DRILLING COMPANY

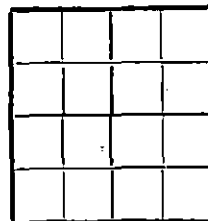

CASING 8-5/8" @ 219' w/200 sax.

ELEVATION 1827' DF

PRODUCTION D & A

FIGURES INDICATE BOTTOM OF FORMATIONS

155	Surface soil & sand
219	Blue shale
270	Shale
640	Red bed
680	Anhydrite
1350	Shale
1500	Shale & lime
1900	Lime
2976	Lime & shale
3060	Lime
3168	Lime & shale
3456	Lime
3456	T. D.

RECEIVED
STATE CORPORATION COMMISSION

AUG 16 1962

CONSERVATION DIVISION
Wichita, Kansas

State of KANSAS }
County of BARTON } SS

I, VERNE A. MORRIS of GARVEY DRILLING COMPANY

upon oath state the above and foregoing is a true and correct copy of the log of the #1 TONKIN "C" well.

Verne A. Morris

Subscribed and sworn to before me this 13th day of August 1962

My Commission Expires: April 14, 1963

Arthur J. Miller
NOTARY PUBLIC