


STATE OF KANSAS  
STATE CORPORATION COMMISSION

## WELL PLUGGING RECORD

Give All Information Completely  
Make Required Affidavit  
Mail or Deliver Report to  
Conservation Division  
State Corporation Comm.  
245 North Water  
Wichita, KS 67202

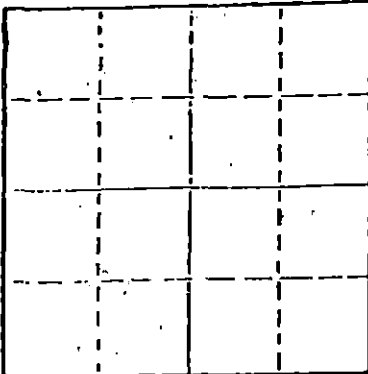

Locate well correctly on above  
Section Plat

Barton County, Sec. 9 Twp. 20 Rge. 12 E/W  
Location as "NE/CNW $\frac{1}{4}$ SW $\frac{1}{4}$ " or footage from lines  
SE NW NE

Lease Owner National Oil Company  
Lease Name Brining #2 Well No. \_\_\_\_\_  
Office Address Wichita, Kansas  
Character of Well (Completed as Oil, Gas or Dry Hole) \_\_\_\_\_

Date Well completed \_\_\_\_\_ 19\_\_\_\_  
Application for plugging filed \_\_\_\_\_ 19\_\_\_\_  
Application for plugging approved \_\_\_\_\_ 19\_\_\_\_  
Plugging commenced 9/7/78 \_\_\_\_\_ 19\_\_\_\_  
Plugging completed 9/12/78 \_\_\_\_\_ 19\_\_\_\_  
Reason for abandonment of well or producing formation \_\_\_\_\_

depleted.  
If a producing well is abandoned, date of last production \_\_\_\_\_ 19\_\_\_\_

Was permission obtained from the Conservation Division or  
its agents before plugging was commenced? yes

Name of Conservation Agent who supervised plugging of this well Rankin  
Producing formation \_\_\_\_\_ Depth to top \_\_\_\_\_ Bottom \_\_\_\_\_ Total Depth of Well 3414  
Show depth and thickness of all water, oil and gas formations.

## OIL, GAS OR WATER RECORDS

## CASING RECORD

FORMATION	CONTENT	FROM	TO	SIZE	PUT IN	PULLED OUT
				8-5/8	210	none
				5 1/2"	3380	2416'

Describe in detail the manner in which the well was plugged, indicating where the mud fluid was placed and the method or methods used in introducing it into the hold. If cement or other plugs were used, state the character of same and depth placed, from \_\_\_\_\_ feet to \_\_\_\_\_ feet for each plug set.

Sanded to 3375' and ran 5 sacks cement. Shot pipe at 2600', 2510', 2405', pulled 77 joints. Squeezed hole with 4 sacks hulls, 25 sacks gel, released plug and displaced with 100 sacks cement, 50/50 pozmix, 4% gel.

PLUGGING COMPLETE.

(If additional description is necessary, use BACK of this sheet)

Name of Plugging Contractor KELSO CASING PULLING  
CHASE, KANSAS


STATE OF KANSAS COUNTY OF RICE, ss.  
R. DARRELL KELSO (employee of owner) or (owner or operator)  
of the above-described well, being first duly sworn on oath, says: That I have knowledge of the facts, statements, and matters herein contained and the log of the above-described well as filed and that the same are true and correct. So help me God.

(Signature)

CHASE, KANSAS

(Address)

SUBSCRIBED AND SWORN TO before me this 13th day of Sept., 1978

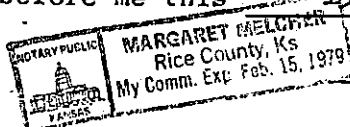

Margaret Melcher  
Notary Public.

My commission expires \_\_\_\_\_

RECEIVED  
STATE CORPORATION COMMISSION

SEP 15 1978

9-15-78

CONSERVATION DIVISION  
Wichita, Kansas

K. T. WOODMAN  
RES. PHONE AM 5-3572  
OFFICE PH. AM 5-7650  
WICHITA, KANSAS

D. J. IANNITTI  
TELEPHONE 653-2381  
HDSINGTON, KANSAS

WOODMAN & IANNITTI DRILLING COMPANY  
*Rotary Drilling Contractors*

706 UNION NATIONAL BUILDING  
WICHITA, KANSAS 67202

January 13, 1970

Company:	National Oil Company
Farm:	Brining No. 2
Location:	SE NW NE
Section:	9-20-12W
County:	Barton
Total Depth:	3400'
Comm:	January 4, 1970
Compl:	January 11, 1970
Casing:	8 5/8 @ 210 w/200 sx
	5 1/2 @ 3380 w/100 sx

Figures Indicate Bottom Of Formations:

150	Sand
210	Blue Shale
280	Sahle
625	Red Bed
650	Anhy
942	Shale & Salt
1485	Shale
1700	Lime
1920	Lime
2085	Lime
2440	Lime & Shale
2670	Lime
2795	Lime
2910	Lime
3018	Lime
3120	Lime & Shale
3185	Lime
3205	Lime
3250	Lime
3305	Lime
3324	Lime
3400	Lime

I certify the above to be a true and correct copy of the driller's log and the geological tops to the best of my knowledge and belief.

Woodman & Iannitti Drilling Co.

*K. T. Woodman*  
K. T. Woodman