


STATE OF KANSAS
STATE CORPORATION COMMISSION

WELL PLUGGING RECORD

Give All Information Completely
Make Required Affidavit
Mail or Deliver Report to:
Conservation Division
State Corporation Commission
212 No. Market
Wichita, Kansas 67202

NORTH

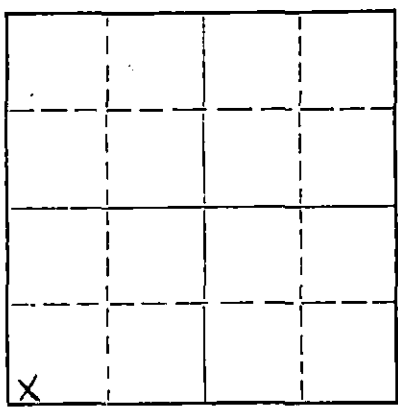

Locate well correctly on above Section Plat

Barton County, Sec. 4 Twp. 20 Rge. 12 (E) W (W)
Location as "NE/CNW*SW*" or footage from lines. SW SW SW
Lease Owner Raymond M. Goodin
Lease Name Tonkin Well No. # 1
Office Address 209 Brown Building ; Wichita, Kansas 67202
Character of Well (completed as Oil, Gas or Dry Hole) _____
Date well completed _____ 19__
Application for plugging filed April 1971
Application for plugging approved April 1971
Plugging commenced April 6 1971
Plugging completed April 9 1971
Reason for abandonment of well or producing formation _____

If a producing well is abandoned, date of last production _____ 19__
Was permission obtained from the Conservation Division or its agents before plugging was commenced? Yes

Name of Conservation Agent who supervised plugging of this well Don Truan
Producing formation _____ Depth to top _____ Bottom _____ Total Depth of Well _____ Feet
Show depth and thickness of all water, oil and gas formations.

OIL, GAS OR WATER RECORDS

CASING RECORD

FORMATION	CONTENT	FROM	TO	SIZE	PUT IN	PULLED OUT
				10 3/4	203	None
				5 1/2	3463	1795

Describe in detail the manner in which the well was plugged, indicating where the mud fluid was placed and the method or methods used in introducing it into the hole. If cement or other plugs were used, state the character of same and depth placed, from _____ feet to _____ feet for each plug set.

April 6, 1971 Plugged off bottom. Dumped sand to 3100'. Mixed and dumped 5 sx of cement to 3060'.
April 9, 1971 Plugged off top. Globe Oil Well Cementing Co. mixed and pumped down 10 3/4" surface casing; 3 sx of hulls, 20 sx gel and 100 sx of cement + 4% gel.

RECEIVED
STATE CORPORATION COMMISSION

1972


CONSERVATION DIVISION
Wichita, Kansas

8-30-72

(If additional description is necessary, use BACK of this sheet)

Name of Plugging Contractor Russ Casing Pulling, Inc.
Address P. O. Box 1082 Great Bend, Kansas 67530

STATE OF KANSAS, COUNTY OF SEDGWICK, ss.
Raymond M. Goodin (as lease owner) or (owner or operator) of the above-described well, being first duly sworn on oath, says: That I have knowledge of the facts, statements, and matters herein contained and the log of the above-described well as filed and that the same are true and correct. So help me God.

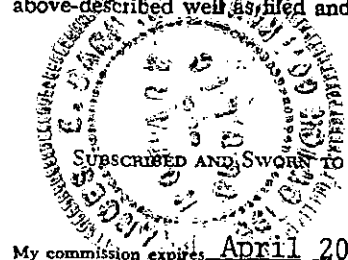

(Signature) Raymond M. Goodin
Raymond M. Goodin
209 Brown Building, Wichita, Kansas 67202
(Address)

SUBSCRIBED AND SWORN to before me this 29th day of August, 19 72

Frances E. Barham
Notary Public.

My commission expires April 20, 1975

DRILLERS LOG

TONKIN NO. 1 (WASHDOWN)


CASING RECORD:	COMPANY:	Raymond M. Goodin	DESCRIPTION:
10-3/4" @ 203'	CONTRACTOR:	Sage Drilling Co.	SW SW SW Sec. 4-20S-12W Barton County, Kansas
LOG TOTAL DEPTH: 3463'	COMMENCED:	December 21, 1967	
	COMPLETED:	December 23, 1967	

<u>FROM</u>	<u>TO</u>	<u>REMARKS</u>
0	3463	Washed down hole; Logged; Set 5½" @ 3462' w/160 sax

I certify that this is a true and correct copy of the operations in the washdown of the above captioned well to the best of my knowledge.

SAGE DRILLING CO., INC.

By *Thomas M. McCaul, Jr.*
 Thomas M. McCaul, Jr.

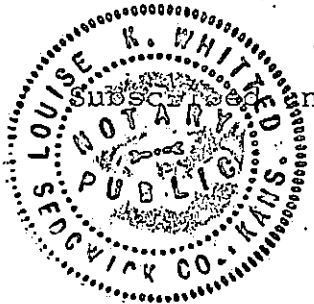

and sworn to before me this 26th day of December, 1967.

Louise K. Whitted
 Louise K. Whitted, Notary Public

My commission expires:
November 26, 1970.

WELL LOG BUREAU - KANSAS GEOLOGICAL SOCIETY.
412 Union National Bank Bldg, Wichita, Kansas.

COPY


J.M. MORROW ET AL.
Tonkin No. 1.

SEC. 4 T. 20 R. 12W.
SW SW - SW
SW-SW-SW

Total Depth, 3450
Coma. 4-1-40 Comp. 4-22-40
Shot or Treated.
Contractor, The McPherson Drlg. Co.
Issued, 8-24-40

County Barton.

Continental

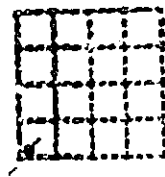

Rotary.

CASING.

103/4" 203'

Elevation, 1816

Production, DRY.

Figures Indicate Bottom of Formations.

shale and shells	202	shale	2600
shale and red rock	632	broken lime	2630
anhydrite	650 ¹⁸⁴	shale	2664
shale and shells	1090	lime	2700
shale and lime	1130	shale	2745
shale and salt	1330	lime	2755
shale	1425	broken lime	2810
lime	1690	lime	2860
red rock	1705	shale and shells	2880
broken lime	1830	lime	2962
lime	1840	broken lime	2985
shale and lime	1920	lime	3025
shale	1965	broken lime	3065
shale and shells	1990	shale	3141
broken lime	2095	lime	3324
sdv lime	2115	Porous lime	3330
lime	2145	lime	3360
broken lime	2190	shale	3415
lime	2230	lime Arbuckle	3425
shale and shells	2345	cored 3425 to 3450	
broken lime	2390	Arbuckle lime	3450
shale	2440	Total Depth.	
red rock	2455		
lime	2480		
broken lime	2520		
lime	2550		
broken lime	2595		