


Give All Information Completely
Make Required Affidavit
Mail or Deliver Report to:
Conservation Division
State Corporation Commission
800 Bittling Building
Wichita, Kansas

WELL PLUGGING RECORD

NORTH

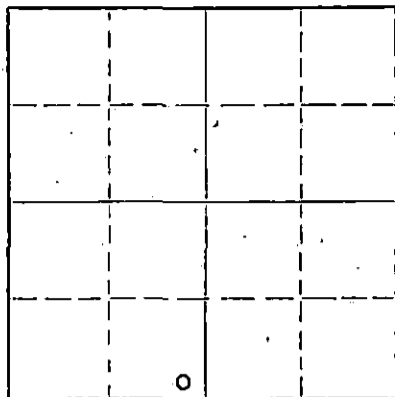

Locate well correctly on above
Section Plat

Barton County. Sec. 34 Twp. 20S Rge. 13 (S) (W)
Location as "NE/CNW/SW" or footage from lines SE SE SW
Lease Owner Petroleum, Inc.
Lease Name Tucker 'D' Well No. 1
Office Address 305 East Third, Wichita, Kansas.
Character of Well (completed as Oil, Gas or Dry Hole) Dry Hole
Date well completed March 30, 1953
Application for plugging filed March 30, 1953
Application for plugging approved March 30, 1953
Plugging commenced March 30, 1953
Plugging completed March 30, 1953
Reason for abandonment of well or producing formation Dry Hole

If a producing well is abandoned, date of last production _____ 19____
Was permission obtained from the Conservation Division or its agents before plugging was commenced? Yes

Name of Conservation Agent who supervised plugging of this well Mr. C. D. Stough
Producing formation _____ Depth to top _____ Bottom _____ Total Depth of Well 3630 Feet
Show depth and thickness of all water, oil and gas formations.

OIL, GAS OR WATER RECORDS

CASING RECORD

FORMATION	CONTENT	FROM	TO	SIZE	PUT IN	PULLED OUT
				8 5/8"	214'	None

Describe in detail the manner in which the well was plugged, indicating where the mud fluid was placed and the method or methods used in introducing it into the hole. If cement or other plugs were used, state the character of same and depth placed, from _____ feet to _____ feet for each plug set.

Mudded up to 210' and set wooden plug at 210'.
Placed 1/2 sack hulls on top of plug at 210'.
Cemented and displaced through drill pipe 20
sacks cement onto plug at 210'. Mudded up to
35' and set second wooden plug. Placed 1/2
sack hulls on top of plug at 35'. Filled hole
to bottom of well cellar with 10 sacks cement.

STATE OF KANSAS
CORPORATION COMMISSION
4-3-53

(If additional description is necessary, use BACK of this sheet)
Name of Plugging Contractor Garvey Drilling Company
Address R. R. #2, Great Bend, Kansas

STATE OF KANSAS, COUNTY OF SEDGWICK, ss.
W. W. Fisher (employee of owner) ~~XXXXXX~~ of the above-described well, being first duly sworn on oath, says: That I have knowledge of the facts, statements, and matters herein contained and the log of the above-described well as filed and that the same are true and correct. So help me God.

(Signature) W. W. Fisher
305 East Third, Wichita 2, Kansas
(Address)

SUBSCRIBED AND SWORN to before me this 2nd day of April, 1953
Charlotte Heiderman
Notary Public.

My commission expires October 13, 1954

PLUGGING
FILE SEC 34 T 20 R 13 W
BOOK PAGE 89 LINE 19

DRILLER'S LOG TUCKER 'D' #1

Petroleum, Inc., Operator

Section 34, Twp. 20S, Rge. 13W

Garvey Drilling Company, Contractor

Location: SE SE SW

Drilling Commenced: March 21, 1953

County: Barton County, Kansas

Drilling Completed: March 30, 1953

R.T.D.: 3630'

Casing Record: 8 5/8" @ 21 1/2' w/175 sax

Production: D & A

Figures below indicate bottom of formation:

124	Sand
139	Hard Sand
270	Shale & Sand
753	Red Bed
776	Anhydrite
1665	Shale & Shells
1840	Lime
2080	Lime & Shale
2200	Lime
2665	Shale & Shells
2820	Shale & Lime
3185	Lime
3300	Lime & Shale
3630	Lime
3630'	R.T.D.

Tops:

Heebner:	3150 (-1259)
Brown Lime:	3270 (-1379)
Lansing:	3283 (-1392)
Arbuckle:	3598 (-1707)

I hereby certify that this is a true and correct log of the above mentioned well.

PETROLEUM, INC.

By W.W. Fink

PLUGGING
 FILE SEC 34 T 20 R 13W
 BOOK PAGE 89 LINE 19

RECEIVED
 STATE CONSERVATION COMMISSION
 APR 5 - 1953
 CONSERVATION DIVISION
 Topeka, Kansas

STATE OF KANSAS)
)
 COUNTY OF SEDGWICK)

SS:

Subscribed to and sworn to before me, a Notary Public, in said County and State, this 2nd day of April, 1953.

Charlotte Heidman
 Notary Public

My commission expires: October 13, 1954.