


STATE OF KANSAS
STATE CORPORATION COMMISSION

WELL PLUGGING RECORD

Give All Information Completely
Make Required Affidavit
Mail or Deliver Report to
Conservation Division
State Corporation Comm.
245 North Water
Wichita, KS 67202

Barton County, Sec. 34 Twp. 20S Rge. 13WE/W
Location as "NE/CNW $\frac{1}{4}$ SW $\frac{1}{4}$ " or footage from lines _____

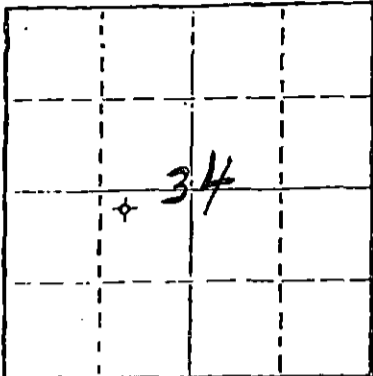

Locate well correctly on above Section Plot

NW NE SW
Lease Owner Lee Banks (Banks Oil Company)
Lease Name Adams Well No. 1
Office Address 200 W. Douglas, Suite 550, Wichita, KS 67202
Character of Well (Completed as Oil, Gas or Dry Hole) _____
Dry Hole

Date Well completed September 13, 19 81
Application for plugging filed September 13, 19 81
Application for plugging approved September 13, 19 81
Plugging commenced September 13, 19 81
Plugging completed September 13, 19 81
Reason for abandonment of well or producing formation _____

Dry Hole
If a producing well is abandoned, date of last production _____ 19 _____

Was permission obtained from the Conservation Division or its agents before plugging was commenced? Yes

Name of Conservation Agent who supervised plugging of this well J. H. Metz
Producing formation _____ Depth to top _____ Bottom _____ Total Depth of Well 3625'
Show depth and thickness of all water, oil and gas formations.

OIL, GAS OR WATER RECORDS

CASING RECORD

FORMATION	CONTENT	FROM	TO	SIZE	PUT IN	PULLED OUT
		0'	280'	8-5/8"	273.81'	None

Describe in detail the manner in which the well was plugged, indicating where the mud fluid was placed and the method or methods used in introducing it into the hold. If cement or other plugs were used, state the character of same and depth placed, from _____ feet to _____ feet for each plug set.

Plugged with plug and 60 sacks cement at 600';
plug and 40 sacks cement at 270'; and plug and
10 sacks cement at 40'; and 10 sacks cement in
rat hole.


(If additional description is necessary, use BACK of this sheet)

Name of Plugging Contractor Allied Cementing Co.

STATE OF KANSAS COUNTY OF SEDGWICK, ss.
John D. Knightley Agent (employee of owner) or (owner or operator)
of the above-described well, being first duly sworn on oath, says: That I have knowledge of the facts, statements, and matters herein contained and the log of the above-described well as filed and that the same are true and correct. So help me God.

(Signature) [Signature]
221 S. Broadway, Suite 400, Wichita, KS 67202
(Address)

SUBSCRIBED AND SWORN TO before me this 18th day of September, 19 81

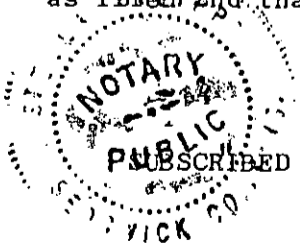

My commission expires March 12, 1983

RECEIVED
Notary Public.
STATE CORPORATION COMMISSION

SEP 22 1981
9-22-81
CONSERVATION DIVISION
Wichita, Kansas

Lee Banks
Banks Oil Company
200 W. Douglas, Suite 550
Wichita, Kansas 67202

Adams #1
NW NE SW Section 34-20S-13W
Barton County, Kansas

Contractor: D. R. Lauck Oil Company, Inc.
221 S. Broadway, Suite 400
Wichita, Kansas 67202

Commenced: September 7, 1981
Completed: September 13, 1981

Drillers Log

Sand	230
Shale	284
Red Bed	1050
Shale & Shells	2590
Shells & Shale	2835
Shale & Lime	3215
Lime & Shale	3310
Lime	3625 RTD

RECEIVED
STATE CORPORATION COMMISSION
SEP 22 1981
CONSERVATION DIVISION
Wichita, Kansas