STATE OF KANSAS
STATE CORPORATION COMMISSION

Give All Information Completely
Make Required Affidavit
Mail or Deliver Report to:
Conservation Division
State Corporation Commission
800 Litting Building
Wichita, Kansas

15-009-00386-0000

WELL PLUGGING RECORD

NORTH

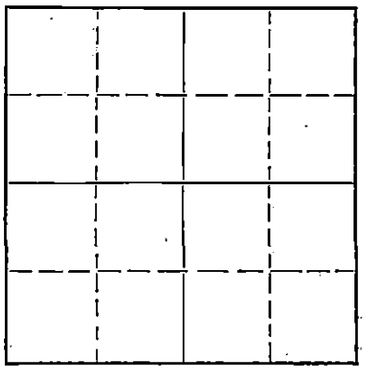

Locate well correctly on above Section Plat

Barton County. Sec. 26 Twp. 20 Rge. (E) 13 (W)

Location as "NE/CNW¼SW¼" or footage from lines NW NW SE

Lease Owner Morris Sitrin

Lease Name Denbo Well No. 1

Office Address Box 1160, Tulsa, Okla.

Character of Well (completed as Oil, Gas or Dry Hole) Dry Hole

Date well completed 10-28-51 19

Application for plugging filed 10-28-51 19

Application for plugging approved 10-28-51 19

Plugging commenced 10-28-51 19

Plugging completed 10-28-51 19

Reason for abandonment of well or producing formation

If a producing well is abandoned, date of last production 19

Was permission obtained from the Conservation Division or its agents before plugging was commenced? Yes

Name of Conservation Agent who supervised plugging of this well C. D. Stough

Producing formation Depth to top Bottom Total Depth of Well 3589 Feet

Show depth and thickness of all water, oil and gas formations.

OIL, GAS OR WATER RECORDS

CASING RECORD

Formation	Content	From	To	Size	Put In	Pulled Out
				8 5/8	245	0

Describe in detail the manner in which the well was plugged, indicating where the mud fluid was placed and the method or methods used in introducing it into the hole. If cement or other plugs were used, state the character of same and depth placed, from feet to feet for each plug set.

Set 1st plug at 230'. Mixed and displaced 15 sacks cement through drill pipe. Filled hole to 30' base of cellar. Set 2nd plug, mixed and displaced 10 sacks cement to surface.

(If additional description is necessary, use BACK of this sheet)

Name of Plugging Contractor Murfin Drilling Co.
Address 910 Un. Natl. Bank Bldg.
Wichita, Ks.

RECEIVED
STATE CORPORATION COMMISSION
NOV - 3 1951
CONSERVATION DIVISION
Wichita, Kansas

STATE OF Kansas, COUNTY OF Sedgwick, ss.

W. R. Murfin (employee of owner) or (owner or operator) of the above-described well, being first duly sworn on oath, says: That I have knowledge of the facts, statements, and matters herein contained and the log of the above-described well as filed and that the same are true and correct. So help me God.

(Signature) W. R. Murfin

Wichita, Ks.
(Address)

SUBSCRIBED AND SWORN TO before me this 2nd day of November, 19 51

Helen Horine
Notary Public.

My commission expires

23-8390-s 6-51—20M

PLUGGING
FILE SEC 26 T 20 R 13W
BOOK PAGE 120 LINE 45

15.009.00386.0000

KANSAS WELL LOG BUREAU --- KANSAS GEOLOGICAL SOCIETY

508 EAST MURDOCK - WICHITA, KANSAS

COMPANY Morris Sitrin

SEC. 26 T. 20 R. 13W

LOC. NW NW SE

FARM Denbo NO. 1

COUNTY Barton

KANSAS

TOTAL DEPTH 3589

COMM. 10-17-51 COMP. 10-28-51

SHOT OR TREATED

CONTRACTOR Murfin Drilling Co.

ISSUED

CASING

20	10	
15	8	245 - Cem. 175 sacks
12	6	
13	5	

ELEVATION 1875 D.F.

PRODUCTION

FIGURES INDICATE BOTTOM OF FORMATIONS

117	sand
150	iron & chert
205	shale (blue) & shells
230	sand
540	sand, red bed
710	red bed
745	Anhydrite
1090	red rock, shale, shells
1540	shale
1880	lime
2205	shale-lime
2735	shale
3140	lime-shale
3494	lime
3570	Congl.
3589	lime

Tops - R.B.

Heebner	3132
Brown Lime	3253
Lans.	3267
Congl.	3496
Arb.	3548
To D.	3589

STATE OF KANSAS)
) SS:
SEDGWICK COUNTY)

I, W. R. Murfin, of the Murfin Drilling Co., upon oath state that the above and foregoing is a true and correct copy of the log of the Denbo No. 1 well.

W. R. Murfin

W. R. Murfin

Subscribed and sworn to before me this 2nd day of November, 1951.

Helen Horine

Notary Public

My Commission Expires: 6-4-55

RECEIVED
STATE CORPORATION COMMISSION
NOV - 3 1951
CONSERVATION DIVISION
Wichita, Kansas

PLUGGING
FILE SEC. 26 T. 20 R. 13W
BOOK PAGE 120 LINE 45