

WELL PLUGGING RECORD

STATE OF KANSAS STATE CORPORATION COMMISSION

Give All Information Completely Make Required Affidavit Mail or Deliver Report to: Conservation Division State Corporation Commission 800 Biting Building Wichita, Kansas

FORMATION PLUGGING RECORD

Strike out upper line when reporting plugging of formations.

Barton County Sec. 25 Twp 20S Rge. (E) 13 (W)

Location as "NE 1/4 NW 1/4 SW 1/4" or footage from lines SW SW NW

Lease Owner W. L. Hartman

Lease Name Hofmaster Well No. 1

Office Address Box 54, Wichita, Kansas

Character of Well (completed as Oil, Gas or Dry Hole) Dry Hole

Date well completed April 24, 1945 19

Application for plugging filed April 24, 1945 19

Application for plugging approved April 24, 1945 19


Plugging commenced April 24, 1945 19

Plugging completed April 24, 1945 19

Reason for abandonment of well or producing formation Dry Hole

If a producing well is abandoned, date of last production --- 19

Was permission obtained from the Conservation Division or its agents before plugging was commenced? Yes

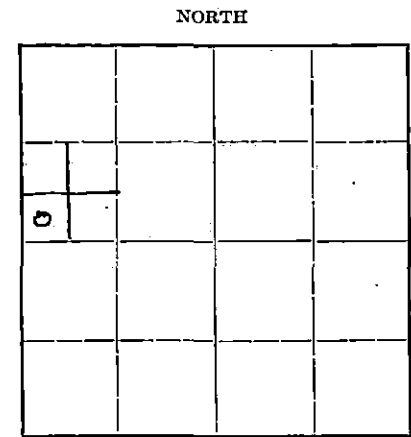

Locate well correctly on above Section Plat

Name of Conservation Agent who supervised plugging of this well Mr. H. W. Kerr

Producing formation --- Depth to top --- Bottom --- Total Depth of Well 3595 Feet

Show depth and thickness of all water, oil and gas formations.

OIL, GAS OR WATER RECORDS


CASING RECORD

Table with 7 columns: Formation, Content, From, To, Size, Put In, Pulled Out. Row 1: Surface, 0, 377', 8 5/8 OD, 377', none.

Describe in-detail the manner in which the well was plugged, indicating where the mud fluid was placed and the method or methods used in introducing it into the hole. If cement or other plugs were used, state the character of same and depth placed, from --- feet to --- feet for each plug set.

Mudded hole back to 377 feet, set bridge, cemented with 15 sacks. Mudded hole back to 20 feet, set bridge, cut surface pipe off at base of cellar, cemented with 10 sacks, cement returning to base of cellar and covering surface pipe at point where it had been cut off.

4-27-45

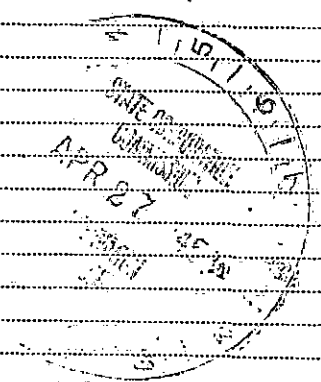

25 20 13W
11 2

(If additional description is necessary, use BACK of this sheet)

Correspondence regarding this well should be addressed to W. L. Hartman Address Box 54, Wichita, Kansas

STATE OF Kansas COUNTY OF Barton ss.

I, G. W. Keyes, drilling contractor (employee of owner) or (owner or operator) of the above-described well, being first duly sworn on oath, says: That I have knowledge of the facts, statements, and matters herein contained and the log of the above-described well as filed and that the same are true and correct. So help me God.

(Signature) G. W. Keyes Ellinwood, Kansas (Address)

SUBSCRIBED AND SWORN to before me this 25th day of April, 1945

My commission expires July 7, 1948 Notary Public.

WELL LOG

W. L. Hartman, Owner - Hofmaster #1

SW Corner NW 1/4 Section 25, Township 20 S, Range 13 W,
Barton County, Kansas

Figures indicate bottom of formation

0	to	132	Sand
		375	Shale and red rock
		695	Red bed and shale
		720	Anhydrite
		1045	Shale
		1340	Salt and shale
Started April 9, 1945		1820	Shale and shells
Abandoned April 24, 1945		1965	Broken lime and shale
		2105	Lime and shells
		2175	Lime
		2184	Iron
		2260	Lime
Surface Pipe 377' 8 5/8 OD		2415	Shale
		2660	Shale, shells and broken lime
		2785	Shale, lime, shells
		2845	Lime
		2945	Shale, shells and lime
		3165	Lime
		3252	Broken lime
		3473	Lime
		3541	Conglomerate
Top Lansing	3252	3595	Arbuckle dolomite
Top Conglomerate	3473		
Top Arbuckle	3541	3595	Total Depth

State of Kansas)
County of Barton) ss

I, G. W. Keyes, Drilling Contractor of the above-described well, being first duly sworn on oath, declare: That I have knowledge of the facts, statements and matters herein contained pertaining to the log of the above-described well as filed and that the same are true and correct.

G. W. Keyes
G. W. Keyes

Subscribed and Sworn to before me this 25th day of April, 1945

25 20 13W
11 2

J. J. Rader
J. J. Rader
Notary Public

My commission expires July 7, 1948.