


STATE OF KANSAS
STATE CORPORATION COMMISSION

WELL PLUGGING RECORD

Information Completely
Required Affidavit
Made or Survey Report to:
Conservation Division
State Corporation Commission
800 Building Building
Wichita, Kansas

Barton County. Sec 29 Twp 20S Rge. 13 (E) W (W)
Location as "NE/CNW/SW" or footage from lines NW, SW, SW,
Lease Owner Frontier Oil Company
Lease Name Woodburn Well No. 1
Office Address _____
Character of Well (completed as Oil, Gas or Dry Hole) Dry Hole
Date well completed 1-4 1954
Application for plugging filed 1-4 1954
Application for plugging approved 1-4 1954
Plugging commenced 1-4 1954
Plugging completed 1-4 1954
Reason for abandonment of well or producing formation Dry Hole

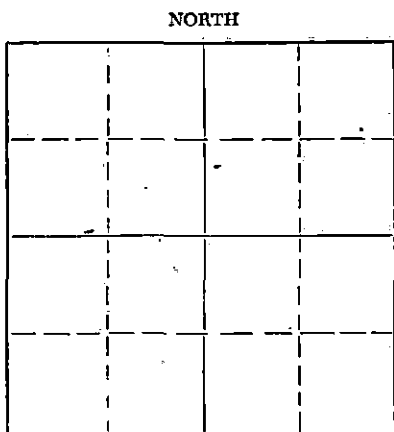

Locate well correctly on above
Section Plat

If a producing well is abandoned, date of last production _____ 19____
Was permission obtained from the Conservation Division or its agents before plugging was commenced? Yes

Name of Conservation Agent who supervised plugging of this well _____
Producing formation _____ Depth to top _____ Bottom _____ Total Depth of Well _____ Feet
Show depth and thickness of all water, oil and gas formations.

OIL, GAS OR WATER RECORDS

CASING RECORD

FORMATION	CONTENT	FROM	TO	SIZE	PUT IN	PULLED OUT
				8 5/8"	135'	0'

Describe in detail the manner in which the well was plugged, indicating where the mud fluid was placed and the method or methods used in introducing it into the hole. If cement or other plugs were used, state the character of same and depth placed, from _____ feet to _____ feet for each plug set.

3462' to 135' Heavy Mud
135' to 132' Howco Plug
132' to _____ 20 Sks. Cement
Top Ground to 40' Mud
40' to Surface 15 Sks. Cement

1-19-54

RECEIVED
STATE CORPORATION COMMISSION
JAN 19 1954
CONSERVATION DIVISION

(If additional description is necessary, use BACK of this sheet)

Name of Plugging Contractor Bud Edwards Drilling Company
Address 206 Rule Building, Wichita, Kansas

STATE OF Kansas COUNTY OF Sedgwick, ss.
Bud Edwards (employee of owner) or (owner or operator) of the above-described well, being first duly sworn on oath, says: That I have knowledge of the facts, statements, and matters herein contained and the log of the above-described well as filed and that the same are true and correct. So help me God.

(Signature) Bud Edwards
206 Rule Building, Wichita, Kansas
(Address)

SUBSCRIBED AND SWORN to before me this 14 day of January, 1954

Louise Burnett
Notary Public.

My commission expires March 14, 1956

24-2675-S 2-52-20M
PLUGGING
FILE SEC 29 TWP 20S R 13W
BOOK PAGE 6 LINE 15

CONTRACTOR'S VERIFIED LOG

Operator Frontier Oil Company Farm Name Woodburn No. 1 Well No. _____

Location NW, SW, SW, 29-20S-13W

Pool Name _____ County Barton State Kansas

Commencement Date 12-26-53 Completion Date 1-4-54

LOG OF WELL

Depth		Formation	Deviation from Vertical (Degrees)	Remarks
From	To			
0'	40'	Shale		
40'	125'	Sand		
125'	132'	Pyrite		
132'	135'	Lime & Shell		
135'	160'	Pyrite W/Sandy Lime		
160'	380'	Shale & Shells		
380'	480'	Red Bed		
480'	750'	Shale & Shells		
750'	780'	Anhydrite		
780'	1050'	Shale w/ Shells		
1050'	1550'	Shale w/ Lime Streaks		
1550'	1635'	Lime w/ Chertz Streaks		
1635'	1760'	Lime w/ Shale Breaks		
1760'	1860'	Lime		
1860'	2270'	Lime w/ Shale Streaks		
2270'	2445'	Shale w/ Lime Streaks		
2445'	2470'	Lime		
2470'	2890'	Lime w/ Shale Streaks		
2890'	3462'	Lime T.D. Plugged		

RECEIVED
 STATE COMMISSION
 JAN 19 1954











