

STATE OF KANSAS  
STATE CORPORATION COMMISSION


Give All Information Completely  
Make Required Affidavits  
Mail or Deliver Report to  
Conservation Division  
State Corporation Commission  
800 Bittling Building  
Wichita, Kansas

WELL PLUGGING RECORD

Barton County. Sec. 29 Twp. 20S Rge. 13 (E) (W)

Location as "NE/CNW/SW" or footage from lines NE NW SW  
Lease Owner Graybol Contracting Corp. & L. B. Smith  
Lease Name McGreevy Well No. 1  
Office Address 523 Petroleum Building Wichita, Kansas  
Character of Well (completed as Oil, Gas or Dry Hole) Dry Hole  
Date well completed August 1, 1953  
Application for plugging filed August 1, 1953  
Application for plugging approved August 5, 1953  
Plugging commenced August 1, 1953  
Plugging completed August 1, 1953  
Reason for abandonment of well or producing formation Dry Hole

NORTH

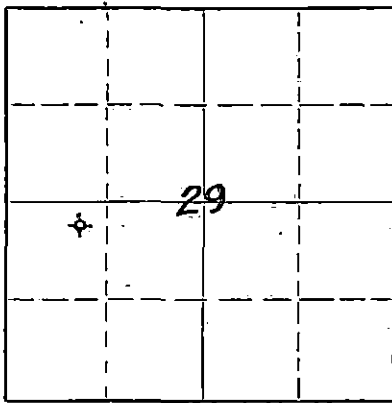

Locate well correctly on above  
Section Plat

If a producing well is abandoned, date of last production \_\_\_\_\_ 19\_\_\_\_  
Was permission obtained from the Conservation Division or its agents before plugging was commenced? Yes

Name of Conservation Agent who supervised plugging of this well C. D. Stough  
Producing formation \_\_\_\_\_ Depth to top \_\_\_\_\_ Bottom \_\_\_\_\_ Total Depth of Well 3478 Feet  
Show depth and thickness of all water, oil and gas formations.

OIL, GAS OR WATER RECORDS

CASING RECORD

FORMATION	CONTENT	FROM	TO	SIZE	PUT IN	PULLED OUT
				8 5/8"	763'	None

Describe in detail the manner in which the well was plugged, indicating where the mud fluid was placed and the method or methods used in introducing it into the hole. If cement or other plugs were used, state the character of same and depth placed, from \_\_\_\_\_ feet to \_\_\_\_\_ feet for each plug set.

Jetted pits and filled hole with heavy mud to 270' - ran 1/3 sack hulls - plug - 20 sax cement through drill pipe. Fill to 45' with mud - ran 1/3 sack hulls - plug - 10 sax cement.

Aug 8 1953  
CONSERVATION DIVISION  
Wichita, Kansas

(If additional description is necessary, use BACK of this sheet)  
Name of Plugging Contractor Graybol Contracting Corp. 8-8-53  
Address 523 Petroleum Building Wichita, Kansas

STATE OF Kansas, COUNTY OF Sedgwick, ss.  
\_\_\_\_\_  
(employee of owner) or (owner or operator) of the above-described well, being first duly sworn on oath, says: That I have knowledge of the facts, statements, and matters herein contained and the log of the above-described well as filed and that the same are true and correct. So help me God.

(Signature) [Signature]  
523 Petroleum Bldg, Wichita, Kan.  
(Address)

SUBSCRIBED AND SWORN TO before me this 8 day of August, 1953

Charles J. Roberts  
Notary Public.

My commission expires My Commission Expires Oct. 31, 1955

PLUGGING  
FILE SEC 29 T 20 R 13W  
CORNER NW 1/4 LINE 34

GRAYBOL CONTRACTING CORPORATION & L. B. SMITH

MC-GREEVY # 1

NE NW SW Sec. 29-20S-13W

Barton County, Kansas

Comm. Drlg.	: 7-21-53	Elevation	: 1898' R. B.
Completed Drlg.	: 8-1-53	Initial Prod	: D & A
Total Depth	: 3478'	Contractor	: Graybol
Completed	:	Tools	: Rotary

CASING RECORD

Run		Left in Hole
763'	8 5/8" surface casing	763' 8 5/8" casing
	5 1/2" casing	5 1/2" casing

STRATA	DEPTH	FORMATION	ROTARY BUSHING TOP
Clay	15	Topeka Lime	2818' (-920)
Sand	135	Heebner Shale	3088' (-1190)
Hard Sand	156	Toronto Lime	3113' (-1215)
Sand, Shale & Shells	252	Brown Lime	3025' (-1307)
Shale	310	Lansing Lime	3211' (-1316)
Red Bed	758	Conglomerate	3450' (-1552)
Gypsum & Anhydrite	784	Granite	3474' (-1576)
Shale & Shells	1250	TOTAL DEPTH	3478' (-1580)
Salt & Shale	1420		
Sandy Lime & Shale	1605	Show of Oil: 3375' - 3385'	
Lime & Shale	2465		
Shale	2590	Drill-Stem Test # 1: 3371' - 3386'	
Shale & Lime	2970	Week blow. Open 1 hour. Recovered 50' Muddy	
Lime	3155	Water. B. H. P. 660# in 15 min.	
Shale & Lime	3206		
Lime	3450	Show of Oil: 3457' - 3460'	
Conglomerate	3474		
Granite	3478	Drill-Stem Test # 2: 3450' - 3460'	
TOTAL DEPTH	3478	Week blow. Open 1 hour. Recovered 30'	
		lightly Oil-Cut Mud. B. H. P. off in 15 min.	

RECEIVED  
 STATE CORPORATION COMMISSION  
 AUG - 9 1953  
 CONSERVATION DIVISION  
 Wichita, Kansas

GRAYBOL CONTRACTING CORPORATION

By [Signature]

STATE OF KANSAS )  
 )  
 COUNTY OF SEDGWICK )

Subscribed and sworn to before me this 8 day of August, 1953

My Commission Expires Oct. 31, 1955

Charles J. Roberts  
 Notary Public

PLUGGING  
 FILE SEC 29-20S-13W  
 BOOK PAGE 119 LINE 34