


WELL PLUGGING RECORD

Give All Information Completely
Make Required Affidavit
Mail or Deliver Report to:
Conservation Division
State Corporation Commission
800 Westing Building
Wichita, Kansas

NORTH

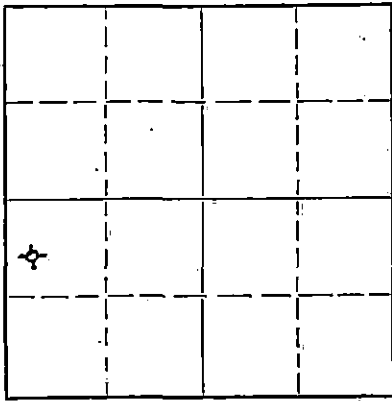

Locate well correctly on above
Section Flat

Barton County. Sec. 29 Twp. 20 Rge. (E) 13 (W)
Location as "NE/CNW/SW" or footage from lines NW - NW - SW
Lease Owner Alden E. Branine
Lease Name McGreevy Well No. 2
Office Address 6429 E. Kellogg Wichita, Kansas
Character of Well (completed as Oil, Gas or Dry Hole) _____
Date well completed _____ 19____
Application for plugging filed _____ 19____
Application for plugging approved _____ 19____
Plugging commenced _____ 6 - 14 1956
Plugging completed _____ 6 - 19 1956
Reason for abandonment of well or producing formation _____

If a producing well is abandoned, date of last production _____ 19____
Was permission obtained from the Conservation Division or its agents before plugging was commenced? YES

Name of Conservation Agent who supervised plugging of this well R. M. Brundage
Producing formation _____ Depth to top _____ Bottom _____ Total Depth of Well _____ Feet
Show depth and thickness of all water, oil and gas formations.

OIL, GAS OR WATER RECORDS

CASING RECORD

| FORMATION | CONTENT | FROM | TO | SIZE | PUT IN | PULLED OUT |
|-----------|---------|------|------|-------|--------|------------|
| | | 0 | 138 | 8 5/8 | | |
| | | 0 | 3576 | 5 1/2 | | |
| | | | | | | |
| | | | | | | |
| | | | | | | |
| | | | | | | |

Describe in detail the manner in which the well was plugged, indicating where the mud fluid was placed and the method or methods used in introducing it into the hole. If cement or other plugs were used, state the character of same and depth placed, from _____ feet to _____ feet for each plug set.

Sanded to 3400' - dumped 5 sks cement - pumped in 20 sks mud, 3 sks hulls, 100 sks cement with 3% Calcium Chloride by Globe Cementing Co.

RECEIVED
STATE CORPORATION COMMISSION
NOV - 7 1956
CONSERVATION DIVISION
Wichita, Kansas

11-3-56

(If additional description is necessary, use BACK of this sheet)
Name of Plugging Contractor R. & D. Casing Pulling Company License # 236
Address Box 569 Ellinwood, Kansas

STATE OF Kansas COUNTY OF Sedgwick ss. XXXXXXXXXXXX
James G. Gould (employee of owner) or (owner or operator) of the above-described well, being first duly sworn on oath, says: That I have knowledge of the facts, statements, and matters herein contained and the log of the above-described well as filed and that the same are true and correct. So help me God.

(Signature) James G. Gould
821 Central Bldg. Wichita, Kansas
(Address)

SUBSCRIBED AND SWORN to before me this 2nd day of November, 1956

My commission expires Feb. 1, 1960
Barbara J. Layton Notary Public.

PLUGGING
FILE SEC. 29 T. 20 R. 13W
BOOK PAGE 72 LINE 35

CONTRACTOR'S WELL LOG

| | |
|-------------|---|
| COMPANY: | Branine Oil Company |
| CONTRACTOR: | Leben Drilling Company |
| FARM: | McGreevey #2 |
| LOCATION: | NW NW SW Sec. 29-20-13 Barton County, Kansas |
| COMMENCED: | September 13, 1955 |
| COMPLETED: | September 24, 1955 |
| PRODUCTION: | Oil |

| | | |
|------|-------------|--|
| 0 | 130 | Surface Sand |
| 130 | 135 | Iron |
| 135 | 160 | Iron |
| 160 | 167 | Shale |
| 167 | 760 | Shale, redbed |
| 760 | 776 | Anhydrite |
| 776 | 1195 | Shale, redbed |
| 1195 | 1567 | Shale |
| 1567 | 1657 | Shale, lime |
| 1657 | 2281 | Lime, shale |
| 2281 | 2687 | Shale, lime |
| 2687 | 3086 | Lime, shale |
| 3086 | 3201 | Shale and lime streaks |
| 3201 | 3284 | Shale and lime |
| 3284 | 3488 | Lime |
| 3488 | 3514 | Conglomerate |
| 3514 | 3546 | Arbuckle Lime |
| | <u>3546</u> | <u>Rotary Total Depth - PRODUCTION</u> |

Set 8 5/8" surface casing at 133.78 feet.

Set 5 1/2" casing at 3495 feet.

RECEIVED

CONSERVATION DIVISION
WORTHINGTON

I, Norma D. Sisson, do hereby certify that the above and foregoing is a true and correct copy of the log of the McGreevey #2, NW NW SW Sec. 29-20-13, Barton County, Kansas, as reflected by the files of the Leben Drilling Company.

LEBEN DRILLING COMPANY

BY: Norma D. Sisson

STATE OF KANSAS)
COUNTY OF SEDGWICK) SS

Subscribed and sworn to before me, a Notary Public, in and for Sedgwick County, Kansas, this 29th day of September, 1955.

Norma D. Sisson
Notary Public

My commission expires April 20, 1959

PLUGGING
FILE SEC. 29 T. 20 R. 13W
BOOK PAGE 72 LINE 35