


STATE OF KANSAS
STATE CORPORATION COMMISSION

WELL PLUGGING RECORD

Give All Information Completely
Make Required Affidavit
Mail or Deliver Report to
Conservation Division
State Corporation Comm.
245 North Water
Wichita, KS 67202

Barton County. Sec. 25 Twp. 20 Rge. 13 X/W
Location as "NE/CNW/SW" or footage from lines
NE NE SW

Lease Owner Mustang Drilling & Exploration, INC.
Lease Name Marmie Well No. #1
Office Address P.O. Drawer 1609, GT. Bend, KS 67530
Character of Well (Completed as Oil, Gas or Dry Hole) Dry Hole

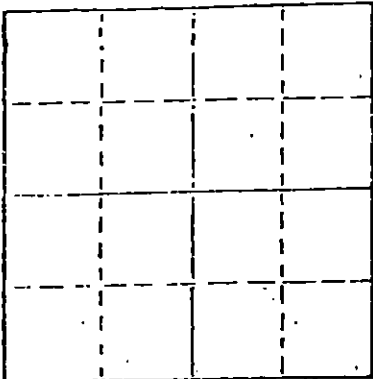

Locate well correctly on above
Section Plot

Date Well completed May 26 1982
Application for plugging filed May 26 1982
Application for plugging approved May 26 1982
Plugging commenced May 26 1982
Plugging completed May 26 1982
Reason for abandonment of well or producing formation D & A

If a producing well is abandoned, date of last production 19.

Was permission obtained from the Conservation Division or its agents before plugging was commenced? yes

Name of Conservation Agent who supervised plugging of this well J.H. Metz, Stafford
Producing formation _____ Depth to top _____ Bottom _____ Total Depth of Well 3600'
Show depth and thickness of all water, oil and gas formations.

OIL, GAS OR WATER RECORDS				CASING RECORD		
FORMATION	CONTENT	FROM	TO	SIZE	PUT IN	PULLED OUT
				8 5/8"	630'	none

Describe in detail the manner in which the well was plugged, indicating where the mud fluid was placed and the method or methods used in introducing it into the hold. If cement or other plugs were used, state the character of same and depth placed, from _____ feet to _____ feet for each plug set.

- 600' 60sx
- 300' 40sx
- 40' 10sx
- rathole 10sx

(If additional description is necessary, use BACK of this sheet)


Name of Plugging Contractor Mustang Drilling & Exploration, Inc.

STATE OF Kansas COUNTY OF Barton, ss.
Gib Overbey (employee of owner) or (owner or operator)
of the above-described well, being first duly sworn on oath, says: That I have knowledge of the facts, statements, and matters herein contained and the log of the above-described well as filed and that the same are true and correct. So help me God.

(Signature) Gib Overbey
P.O. Drawer 1609, Gt. Bend, KS 67530
(Address)

SUBSCRIBED AND SWORN TO before me this 2nd day of June, 1982

My commission expires May 14, 1986

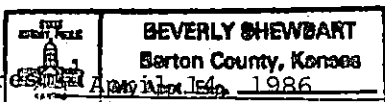

Beverly Shewbart
Notary Public.

RECEIVED
STATE CORPORATION COMMISSION

CONSERVATION DIVISION
Wichita, Kansas

6-7-82

SIDE TWO

WELL LOG

Show all important zones of porosity and contents thereof; cored intervals, and all drill-stem tests, including depth interval tested, cushion used, time tool open, flowing and shut-in pressures, and recoveries.

SHOW GEOLOGICAL MARKERS, LOGS RUN, OR OTHER DESCRIPTIVE INFORMATION.

FORMATION DESCRIPTION, CONTENTS, ETC.	TOP	BOTTOM	NAME	DEPTH
Sand, REdBed	0	515	Heebner	3088
Shale	515	918	Toronto	3108
Shale, Lime	918	1595	Douglas	3124
Lime, Shale	1595	1930	Brown Lime	3212
Shale, Lime	1930	2567	Lansing	3226
Lime, Shale	2567	2815	Base K.C.	3452
Shale, Lime	2815	3088	Conglomerate	3472
Shale	3088	3092	Arbuckle	3560
Shale, Lime	3092	3108	LTD	3600
Lime	3108	3124	RTD	3600
Shale	3124	3212		
Lime, Shale	3212	3226		
Lime	3226	3452		
Lime, Shale	3452	3472		
Lime, Shale, Sand, Chert	3472	3560		
Dolomite	3560	3600		
LTD		3600		
RTD		3600		

Report of all strings set— surface, intermediate, production, etc. CASING RECORD (New) or (Used)

Purpose of string	Size hole drilled	Size casing set (In O.D.)	Weight lbs/ft.	Setting depth	Type cement	Sacks	Type and percent additives
surface	12 1/2	8 5/8	24#	637'	common	325	3%cc; 2% gel

LINER RECORD

PERFORATION RECORD

Top, ft.	Bottom, ft.	Sacks cement	Shots per ft.	Size & type	Depth interval

Size	Setting depth	Packer set at

ACID, FRACTURE, SHOT, CEMENT SQUEEZE RECORD

Amount and kind of material used	Depth interval treated

Date of first production	Producing method (flowing, pumping, gas lift, etc.)	Gravity
RATE OF PRODUCTION PER 24 HOURS	Oil bbls.	Gas MCF
	Water %	Gas-oil ratio bbls. CFPB
Disposition of gas (vented, used on lease or sold)		Perforations

