


STATE OF KANSAS  
STATE CORPORATION COMMISSION

WELL PLUGGING RECORD

Give All Information Completely  
Make Required Affidavit  
Mail or Deliver Report to:  
Conservation Division  
State Corporation Commission  
211 No. Broadway  
Wichita, Kansas

NORTH

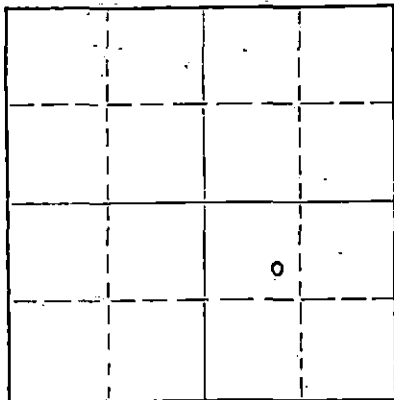

Locate well correctly on above  
Section Plat

Barton County. Sec. 25 Twp. 20s Rge. 13 (E) W (W)  
Location as "NE/CNW/SW" or footage from lines SE NW SE/4  
Lease Owner Virginia Drilling Co., Inc.  
Lease Name Lonnon Well No. 4  
Office Address 712 Brown Bldg., Wichita, Kansas 67202  
Character of Well (completed as Oil, Gas or Dry Hole) dry hole  
Date well completed July 31 1963  
Application for plugging filed July 31 1963  
Application for plugging approved July 31 1963  
Plugging commenced August 1 1963  
Plugging completed August 1 1963  
Reason for abandonment of well or producing formation \_\_\_\_\_

If a producing well is abandoned, date of last production \_\_\_\_\_ 19\_\_\_\_  
Was permission obtained from the Conservation Division or its agents before plugging was commenced? yes

Name of Conservation Agent who supervised plugging of this well Donald Truman, Russell, Kansas  
Producing formation \_\_\_\_\_ Depth to top \_\_\_\_\_ Bottom \_\_\_\_\_ Total Depth of Well 3514 Feet  
Show depth and thickness of all water, oil and gas formations.

OIL, GAS OR WATER RECORDS

CASING RECORD

FORMATION	CONTENT	FROM	TO	SIZE	PUT IN	PULLED OUT
		0	259	8-5/8"	259	none

Describe in detail the manner in which the well was plugged, indicating where the mud fluid was placed and the method or methods used in introducing it into the hole. If cement or other plugs were used, state the character of same and depth placed, from \_\_\_\_\_ feet to \_\_\_\_\_ feet for each plug set.

Mudded to 240' - set plug w/25 sacks cement  
Mudded to 40' - set plug w/12 sacks cement  
Mudded rat hole and put in 3 sacks cement

RECEIVED  
STATE CORPORATION COMMISSION

AUG 7 1963

CONSERVATION DIVISION  
Wichita, Kansas

(If additional description is necessary, use BACK of this sheet)

Name of Plugging Contractor Virginia Drilling Co., Inc.  
Address 712 Brown Bldg., Wichita, Kansas 67202

STATE OF Kansas, COUNTY OF Sedgwick, ss.  
S. A. Murphy (employee of owner) or (owner or operator) of the above-described well, being first duly sworn on oath, says: That I have knowledge of the facts, statements, and matters herein contained and the log of the above-described well as filed and that the same are true and correct. So help me God.

(Signature) S. A. Murphy  
712 Brown Bldg., Wichita, Kansas 67202  
(Address)

SUBSCRIBED AND SWORN TO before me this 6th day of August, 1963

My commission expires March 15, 1966  
Inez M. Underwood Notary Public.



Well: Lonnon #4  
 Location: SE NW SE/4 Section 25-20s-13w, Barton Co., Kansas  
 Company: Virginia Drilling Co., Inc.  
 Contractor: Virginia Drilling Co., Inc.  
 Commenced: July 24, 1963  
 Completed: July 31, 1963  
 Total Depth: 3514  
 Elevation: 1863 DF

**RECEIVED**  
 STATE CORPORATION COMMISSION

AUG 7 1963

FORMATION	DEPTH
Sand	0-255
Red Bed shale	255-680
Anhydrite	680-720
Shale-shells	720-1210
Shale	1210-1535
Lime-shale	1535-1625
Shale-shells	1625-1666
Shale-lime	1660-1980
Lime & Shale & Brk Lime	1980-2140
Lime	2140-2340
Shale-lime	2340-2915
Lime	2915-3083
Shale-lime	3083-3275
Lime	3275-3514

CONSERVATION DIVISION  
 Wichita, Kansas

Set 8-5/8" csg. @ 259'  
 w/250 sks. cement

TOPS:

Anhydrite	680
Brown Lime	3216
Heebner	3093
Kansas City	3231
Base K.C.	3466
Conglomerate	3474
Arbuckle	3497

Now comes S. A. Murphy, who states that he is familiar with the drilling of oil and gas wells, and knows of his own knowledge that the Lonnon #4, located in the center of the Southeast of the Northwest of the Southeast Quarter (SE NW SE/4), Section 25-20s-13w, Barton County, Kansas, was drilled to a total depth of 3514 feet. Same was plugged and abandoned.

*S. A. Murphy*  
 S. A. Murphy

Subscribed and sworn to before me, a Notary Public, this 6<sup>th</sup> day of August, 1963.

*Irene M. Underwood*  
 Notary Public

My commission expires March 15, 1966.